


T.40S.R.14W.W.M.

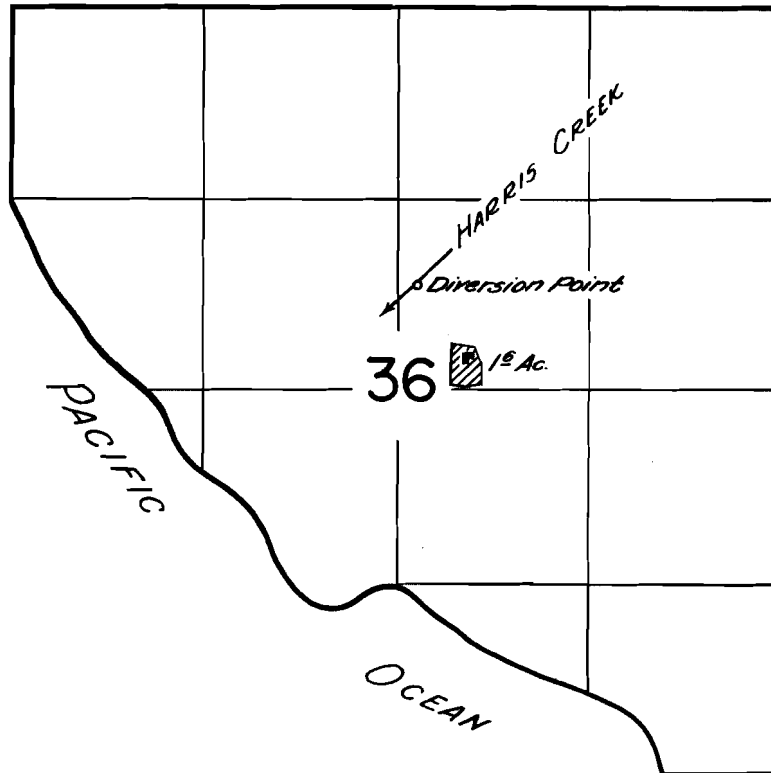

**FINAL PROOF SURVEY**  
UNDER

Application No. 32424. Permit No. 25597.

IN NAME OF  
GUNNAR HEDBERG and  
WESLEY C. & IRIS L. KINDEL

Surveyed Aug. 8, 1963, by T. Lauer.