


T.41S.R.13W.W.M.

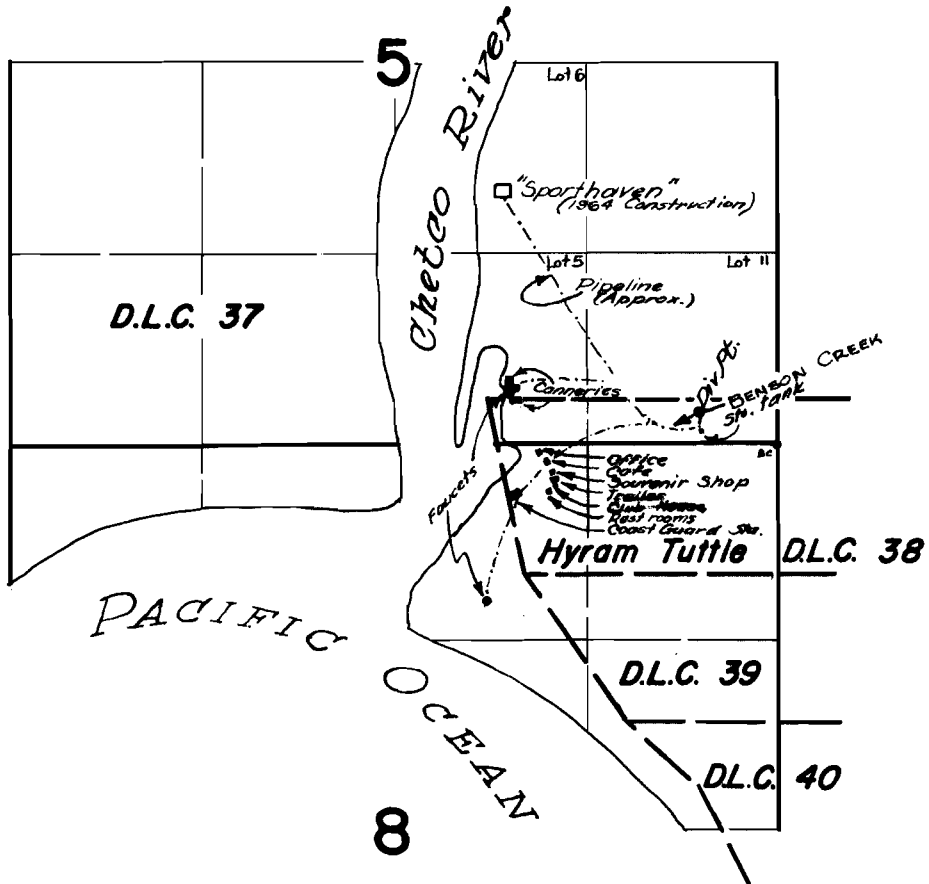

FINAL PROOF SURVEY
UNDER

Application No. 32526... Permit No. 25773...
IN NAME OF

..... B. A. McVAY

Surveyed August 8, 1963, by T. Lauer.....
March 16, 1965, by R. Jackson