


T.41S.R.12W.W.M.

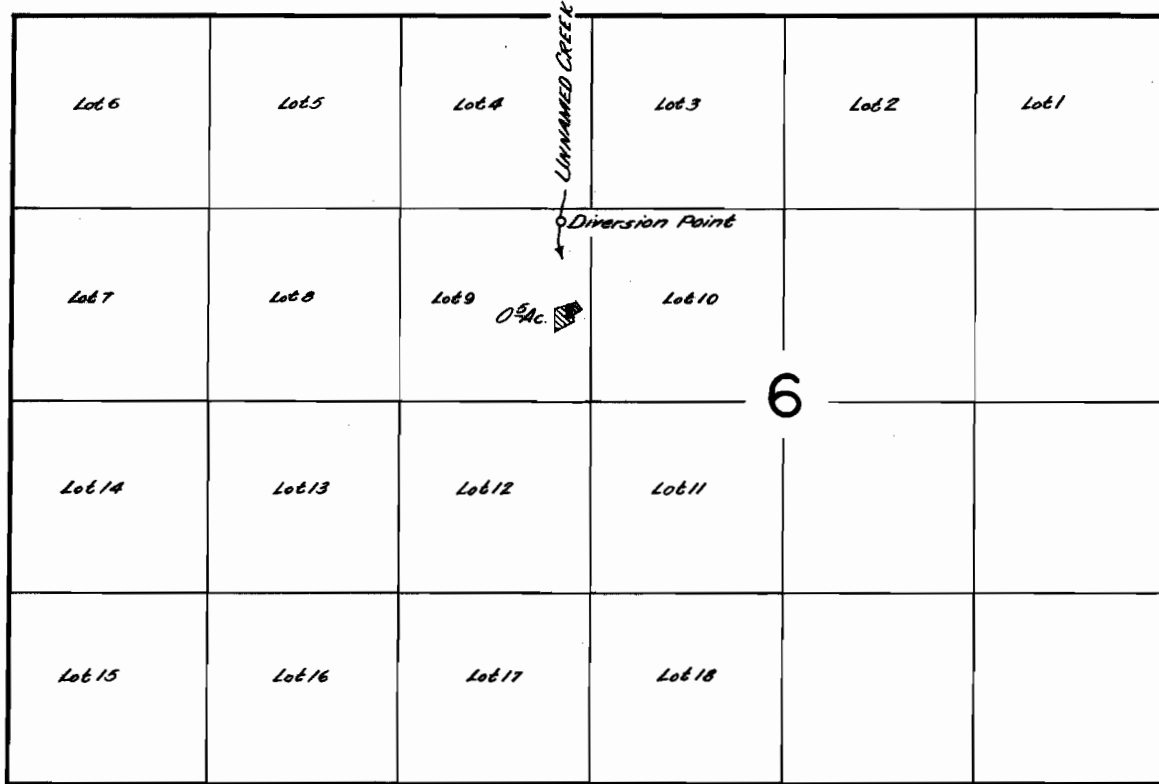

FINAL PROOF SURVEY
UNDER

Application No. 38241... Permit No. 28487...
IN NAME OF

...R. C. or Helen L. Weaver.....

Surveyed Aug. 6... 1963, by T. Lauer.....