


T.24S.R.7W.W.M.

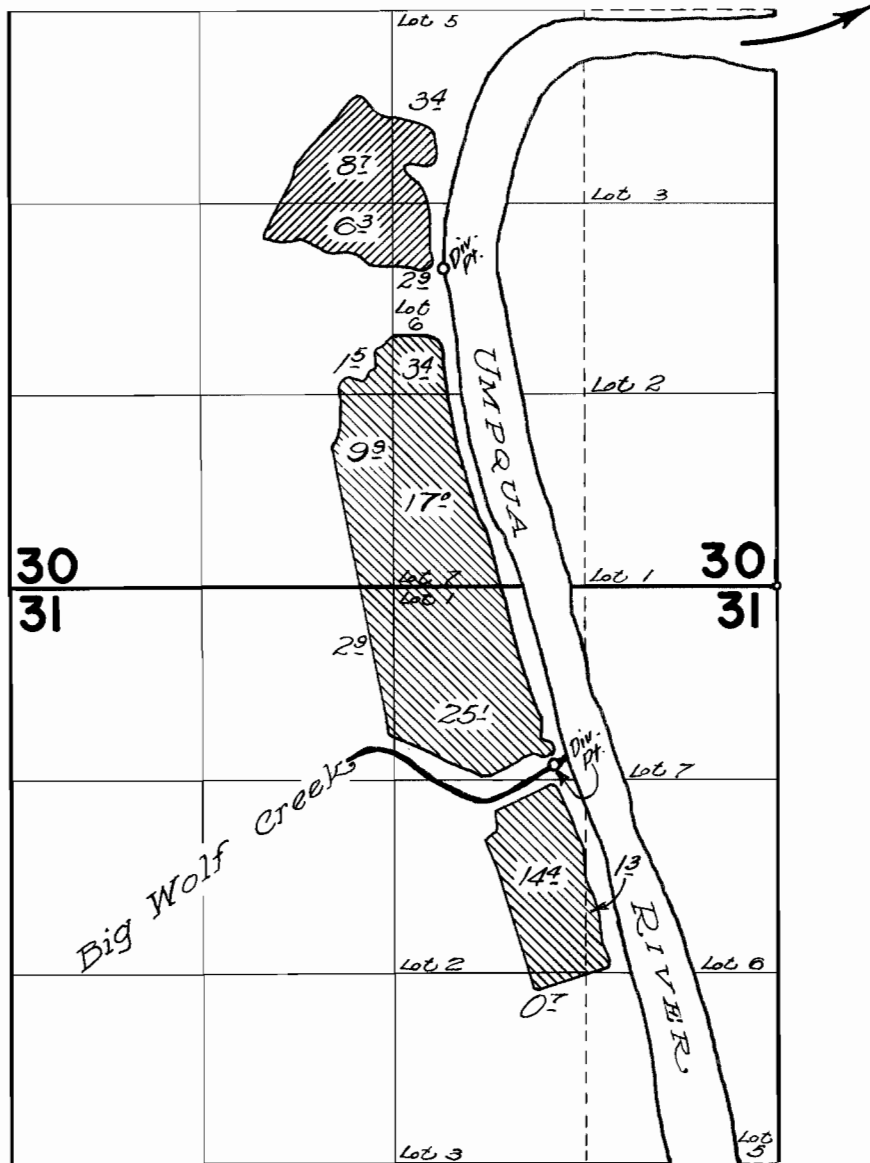

FINAL PROOF SURVEY
UNDER

Application No. 31303... Permit No. 24653
IN NAME OF

ELMA M. DUNCAN

Surveyed June 12 1963 by T. Lauer