


T.22S.R.9W.W.M.

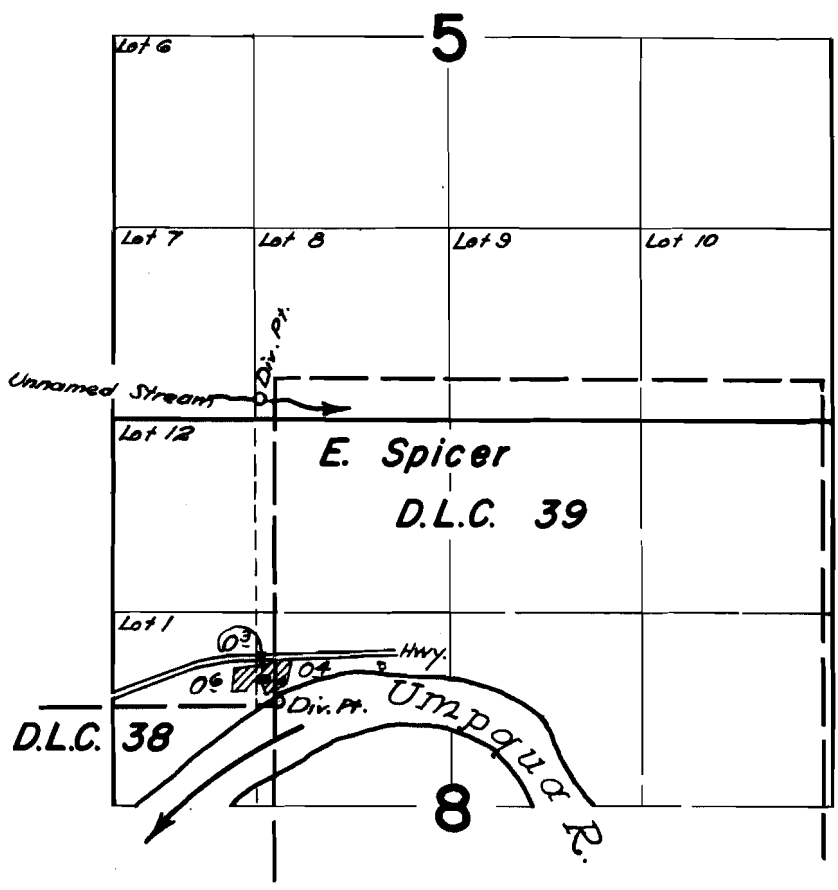

**FINAL PROOF SURVEY**  
UNDER

Application No. 35870... Permit No. 27508...  
IN NAME OF

CHARLES & LENA RANDALL

Surveyed June 14, 1963, by T. Lauer...