

Per. 28022  
32294

DEC 15 1961

KEENEY WORK CENTER


T 10S R 31E Sec. 36

Mapped by WGM

Malheur Natl Forest

Scale 8 inches = 1 Mile

10 May 61

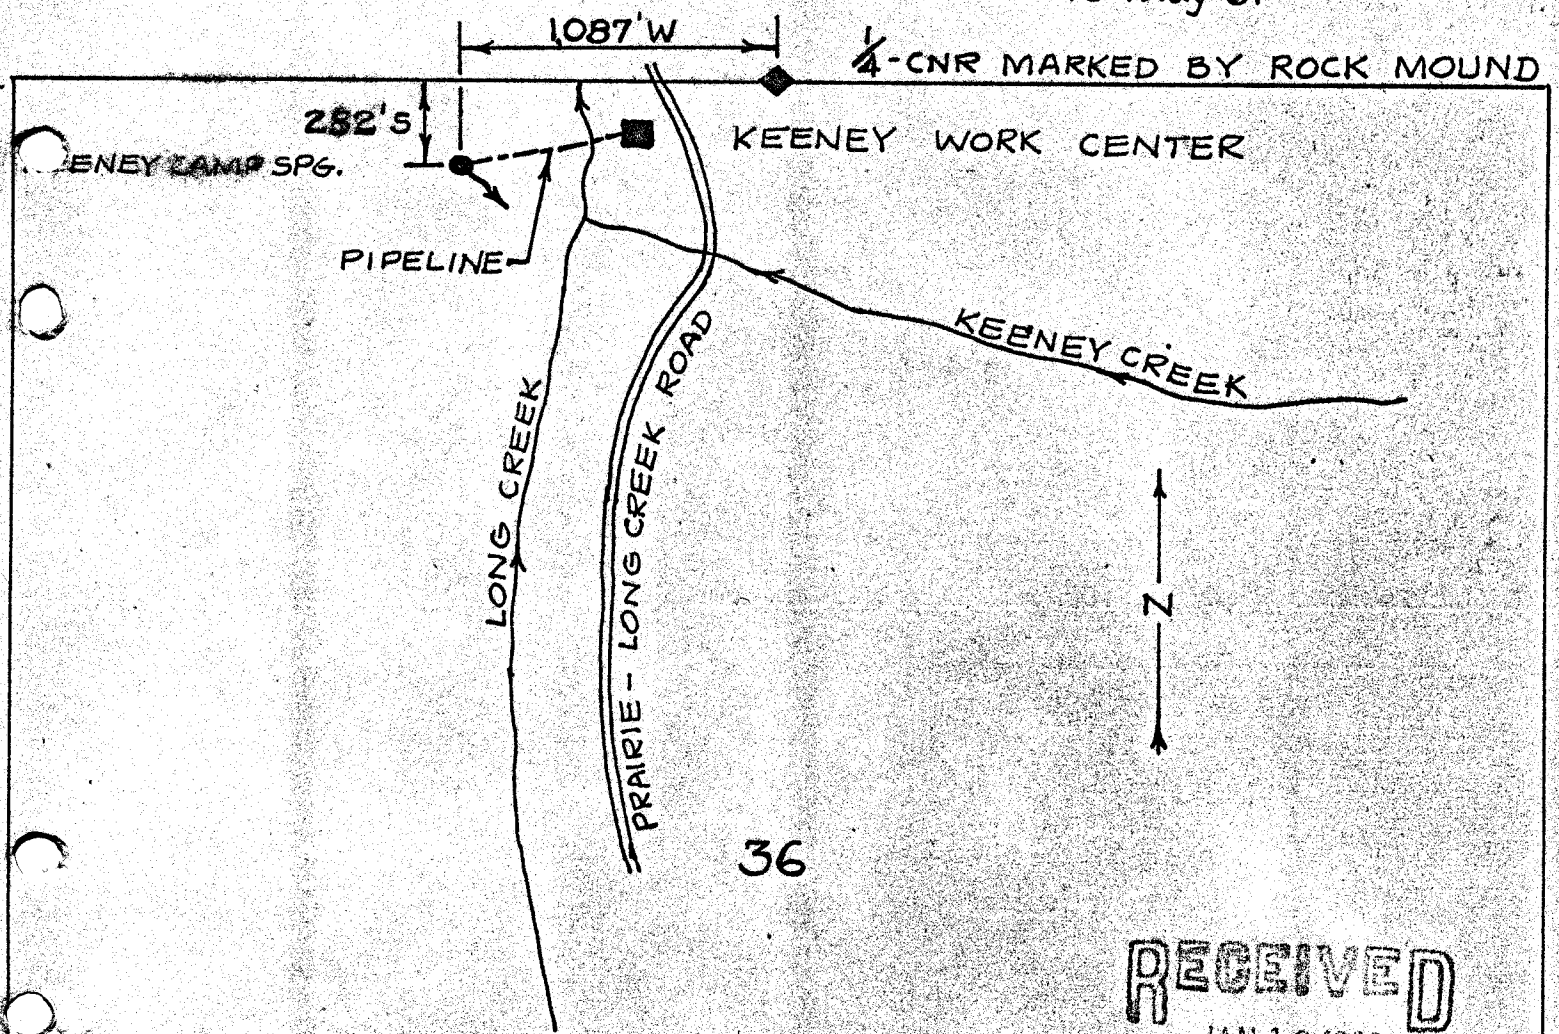

**RECEIVED**  
JAN 12 1962  
STATE ENGINEER  
SALEM, OREGON

Application No. 31305  
Permit No. 28022