


T.13S. R.27E. W.M.

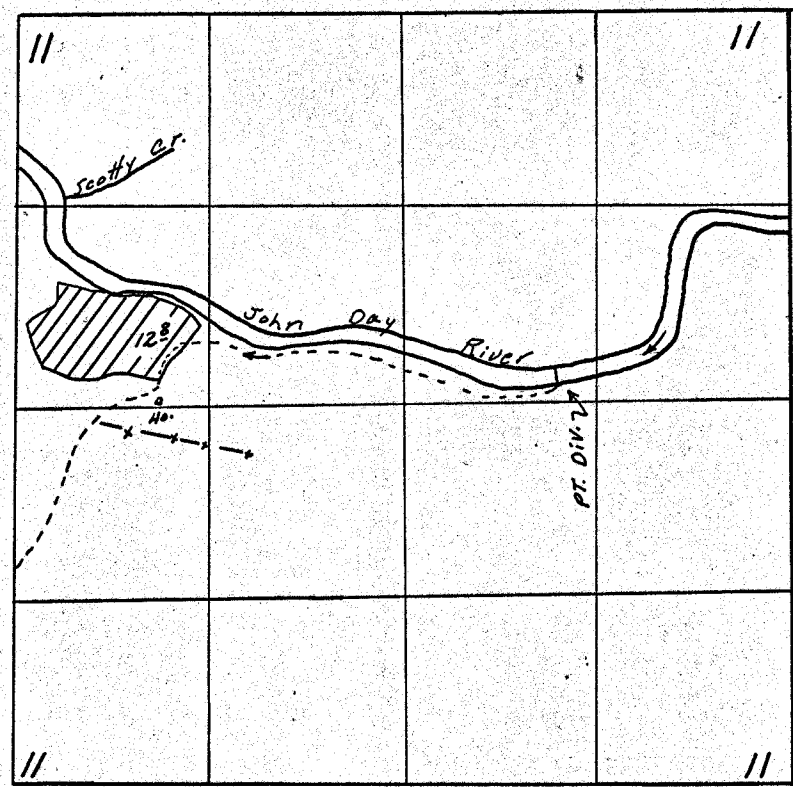

FINAL PROOF SURVEY UNDER

Application No. 37826 Permit No. 22204
IN NAME OF

Pine Tree Lumber Co.

Surveyed June 23 1964 by G. Ward.