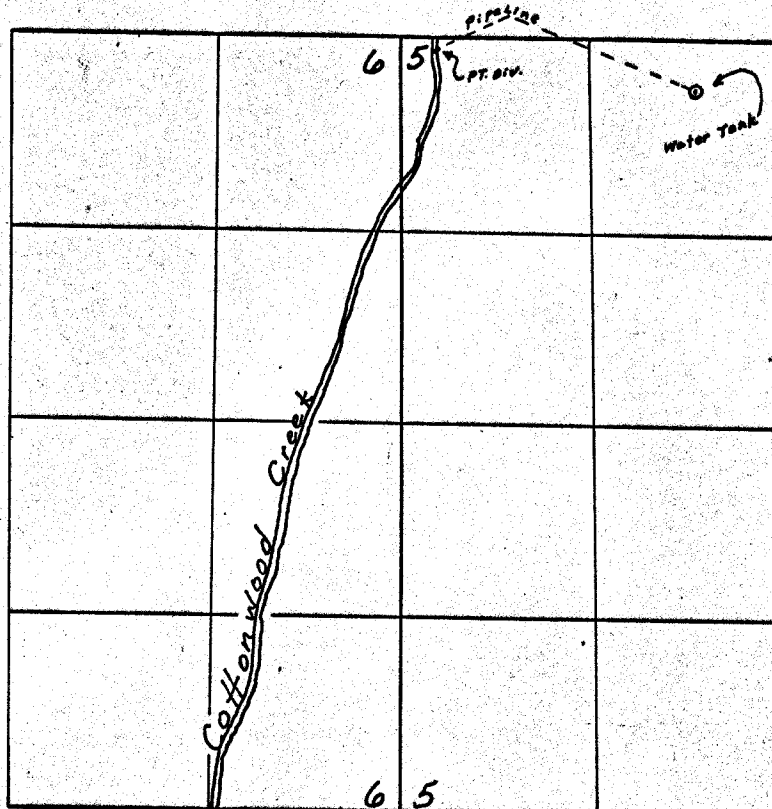


T.13S. R.26E. W.M.

**FINAL PROOF SURVEY**
UNDERApplication No. 38478... Permit No. 28653..
IN NAME OFALEXANDER ROBERTSONSurveyed June 24, 1964, by G. Ward...