


T.13S. R.28E. W.M.

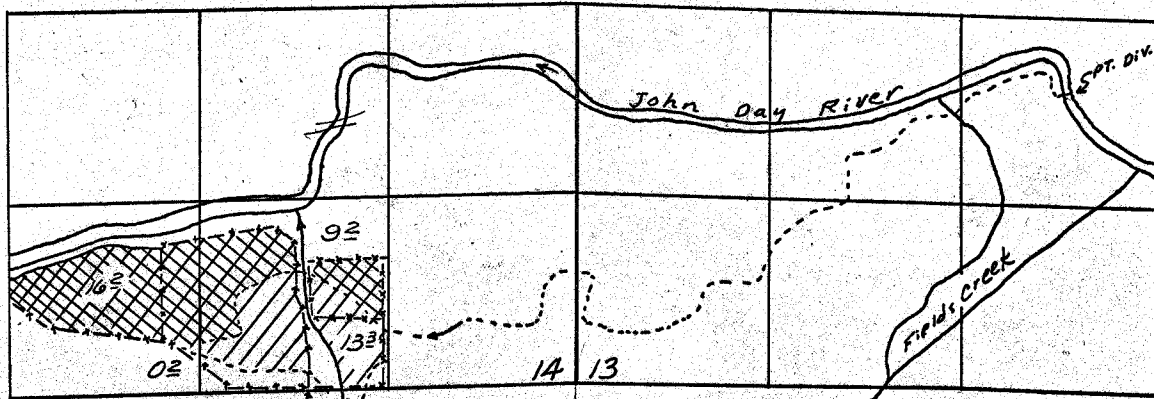

Dry Creek 
 John Day River 

FINAL PROOF SURVEY UNDER

Application No. 38503... Permit No. 28689..
 IN NAME OF

William H. Hyder

Surveyed June 26 1964, by G. Ward