


T.32S.R.32E.W.M.

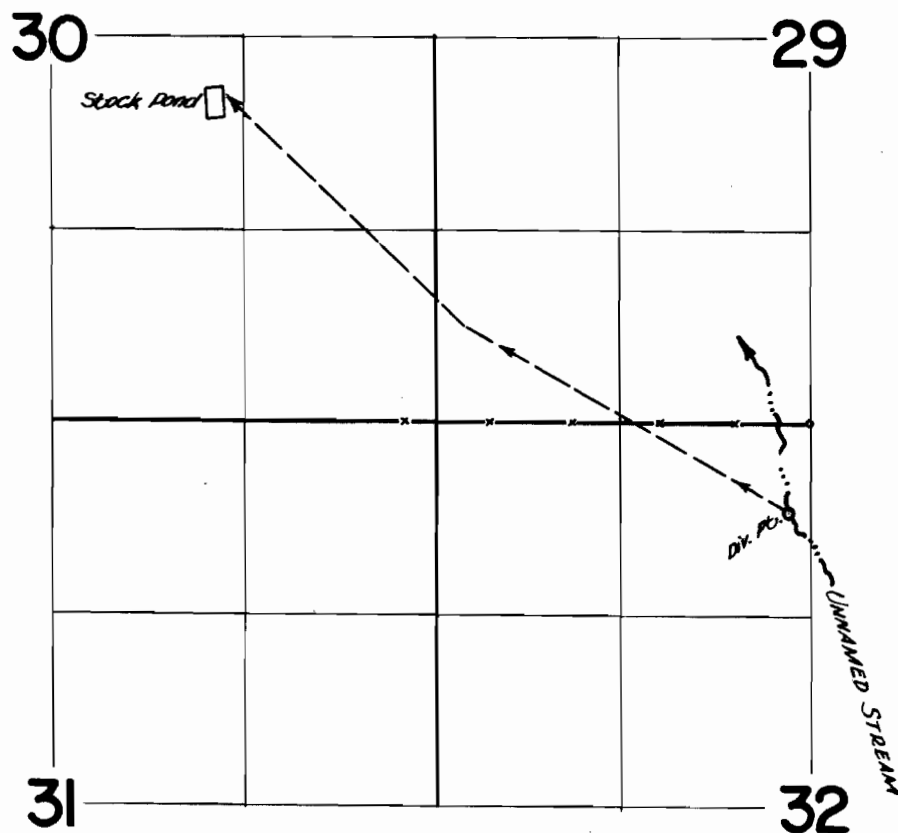

FINAL PROOF SURVEY
UNDER

Application No. 22103..... Permit No. 17419.....
IN NAME OF

ALLIED LAND & LIVESTOCK CO.

Surveyed *August 21 1903*, by *T. Lauer*.....