


T.32S. R.32 1/2E.W.M.

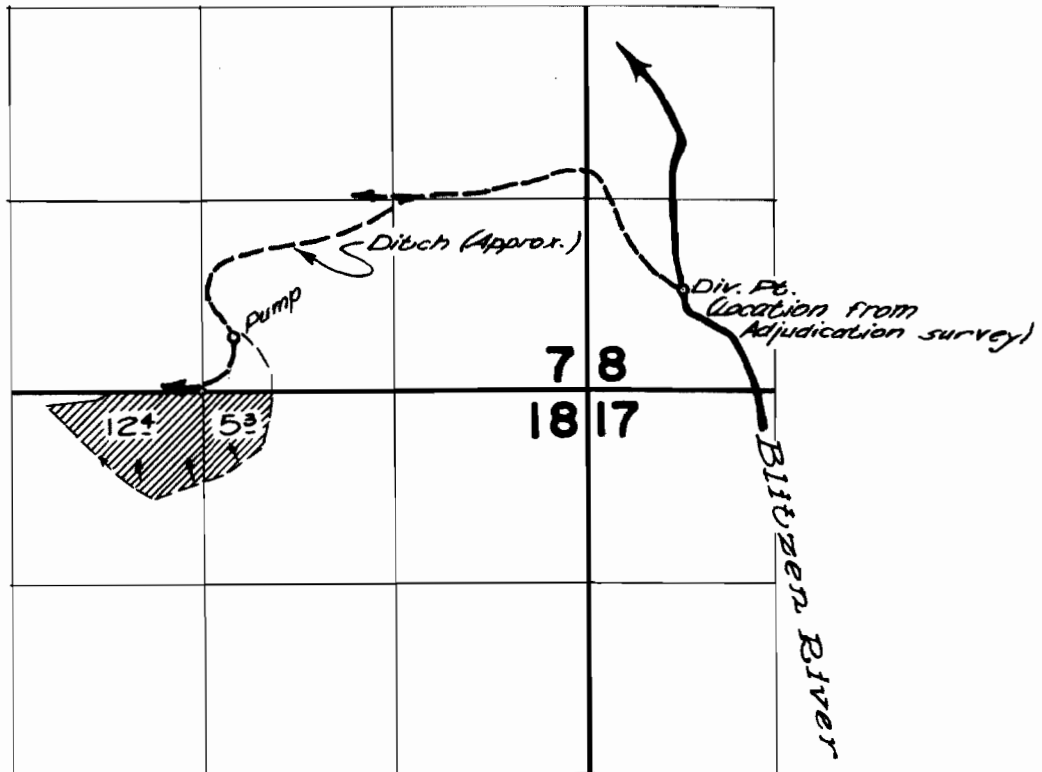

FINAL PROOF SURVEY
UNDER

Application No. 31174..... Permit No. 25465...
IN NAME OF

JACK FINE

Surveyed Aug. 20 1963, by T. Lauer.....