


27452

32302

TWP. 40S.R4E.

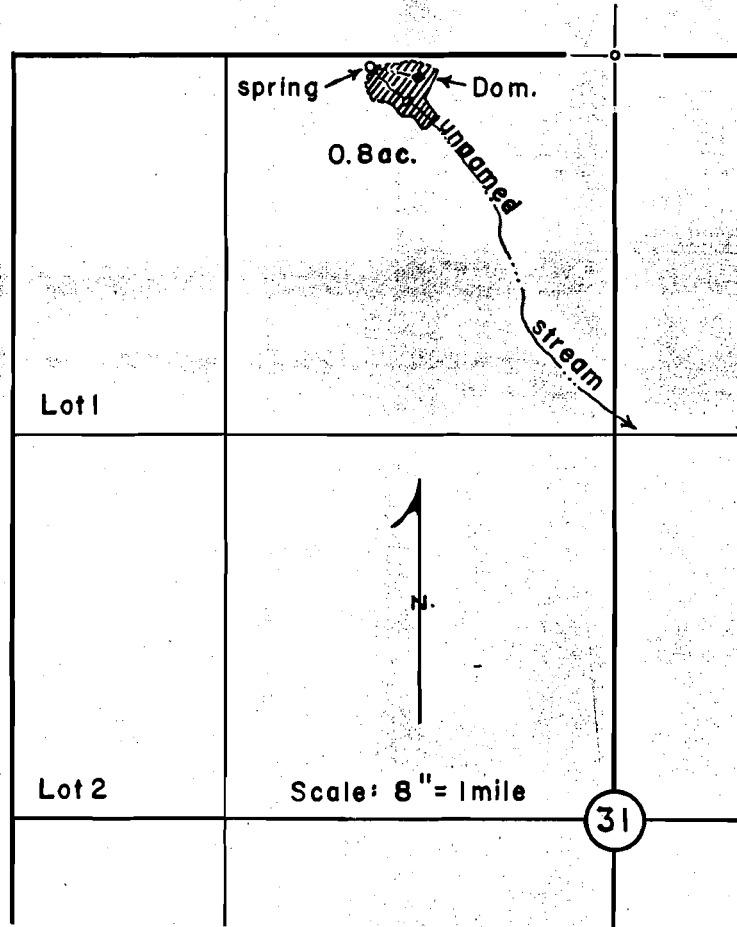

ferry csk. - 1/2 mile.

# FINAL PROOF SURVEY UNDER

Application No. 35067 Permit No. 27452  
IN NAME OF

John H. Miller

Surveyed Aug 28, 1964, by D.C. Hendrix