


T.38S.R.20E.W.M.

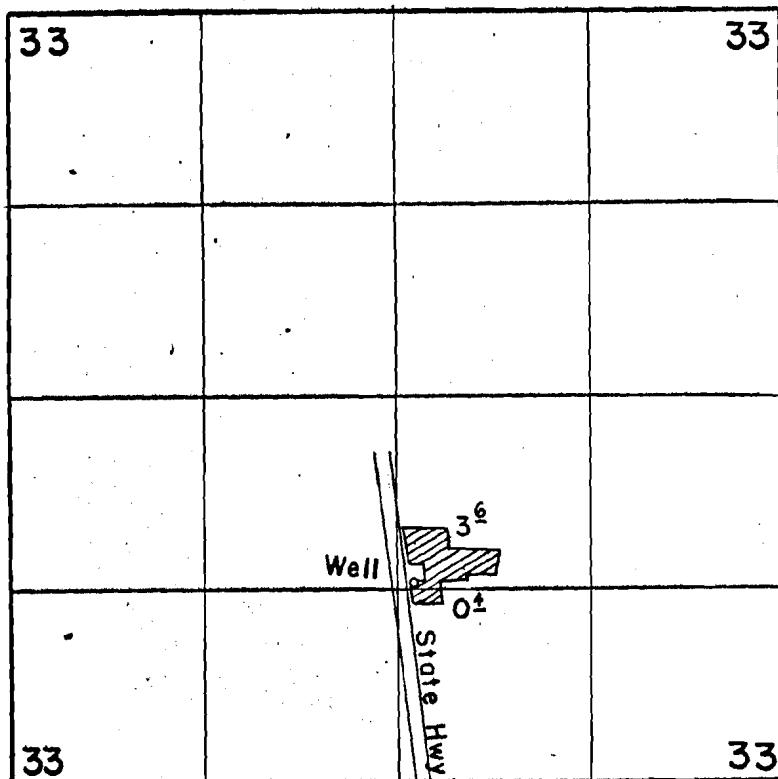

FINAL PROOF SURVEY UNDER

Application No. G-1580.... Permit No. G-1455....
IN NAME OF

.....Robert...Weir...Jr.....

Surveyed Sept...17... 1964, by G.J.Gardner.....