
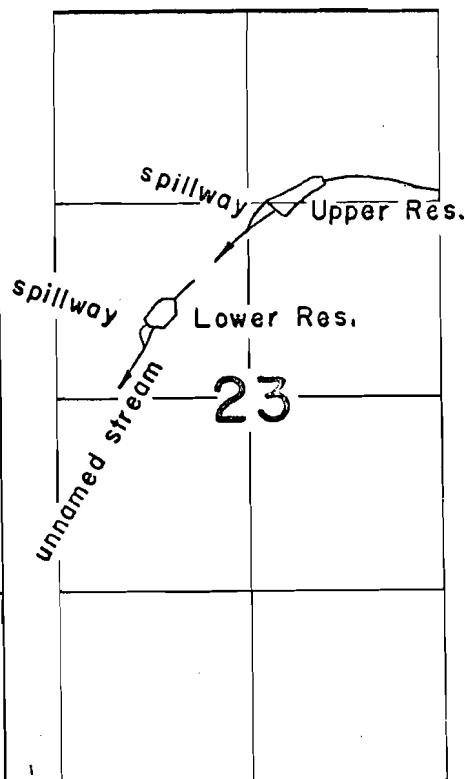


T.38S.R.20E.W.M.

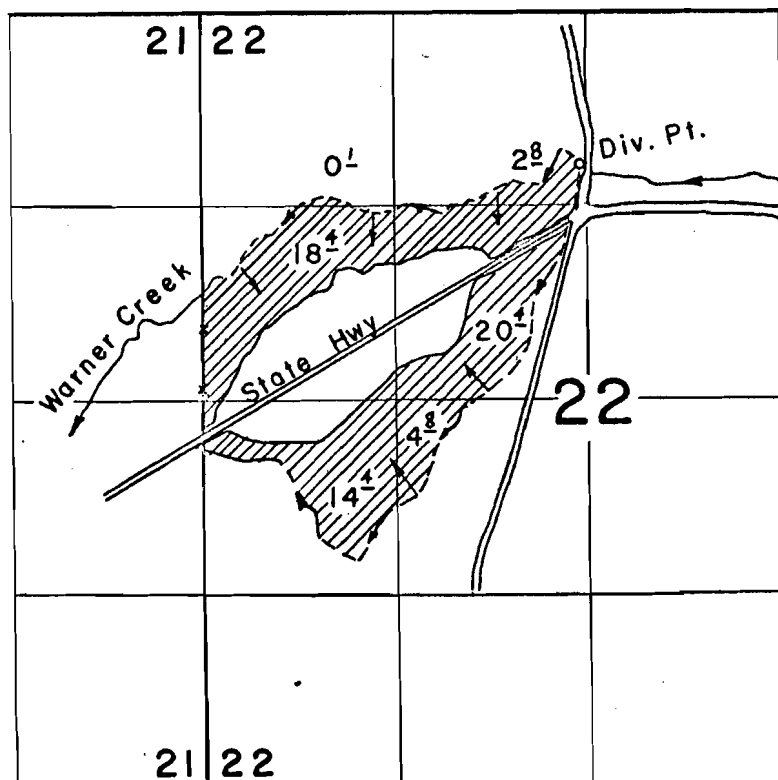

FINAL PROOF SURVEY UNDER

R-33130

R-2257

R-33131

R-2258

Application No. 33209 Permit No. 26257

IN NAME OF

Burton L. Chambers

Surveyed Sept. 13, 1962, by Tom Lauer

Sept. 9, 1964 C.J. Gardner