
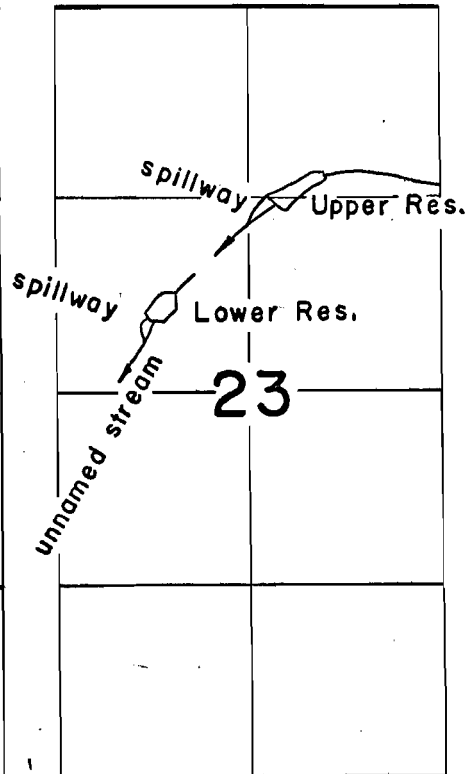


T.38S.R.20E.W.M.

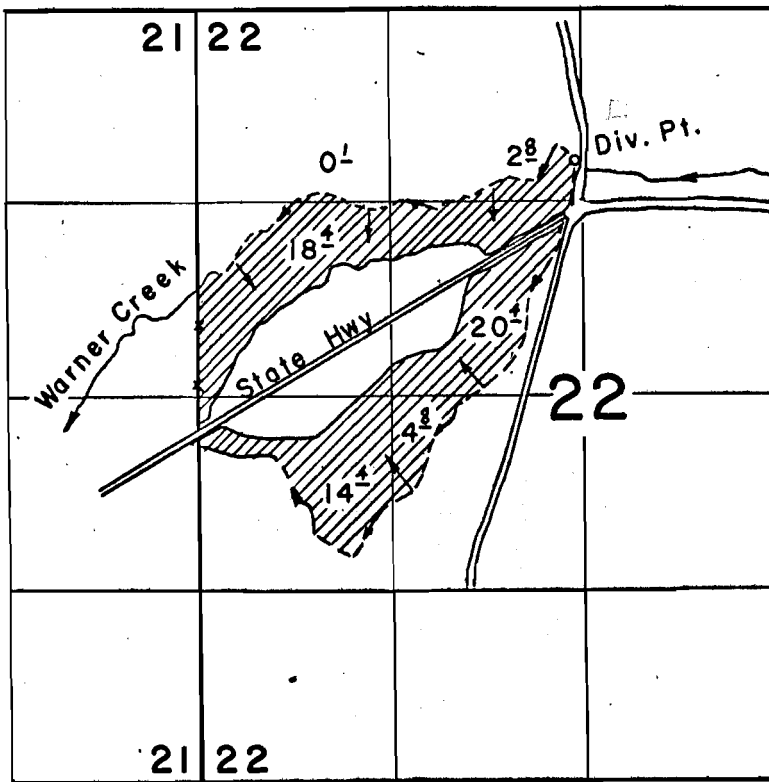

FINAL PROOF SURVEY UNDER

R-33130 R-2257
R-33131 R-2258
Application No. 33209 Permit No. 26257
IN NAME OF

Burton L. Chambers

Surveyed Sept. 13, 1962, by Tom Lauer
Sept. 9, 1964 C.J. Gardner

38-20