


27469
32308

T.41S.R.18E.W.M.

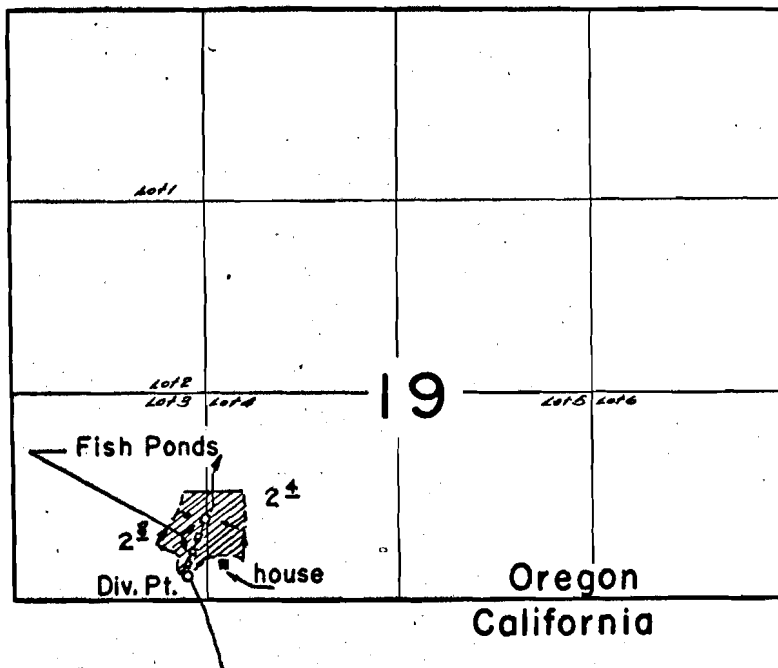

FINAL PROOF SURVEY UNDER

Application No. 34864... Permit No. 27469...
IN NAME OF

.....R. T. Renner.....

Surveyed Sept. 14, 1964., by C. J. Gardner.....

41-18