


T.20S.R.3W.W.M.

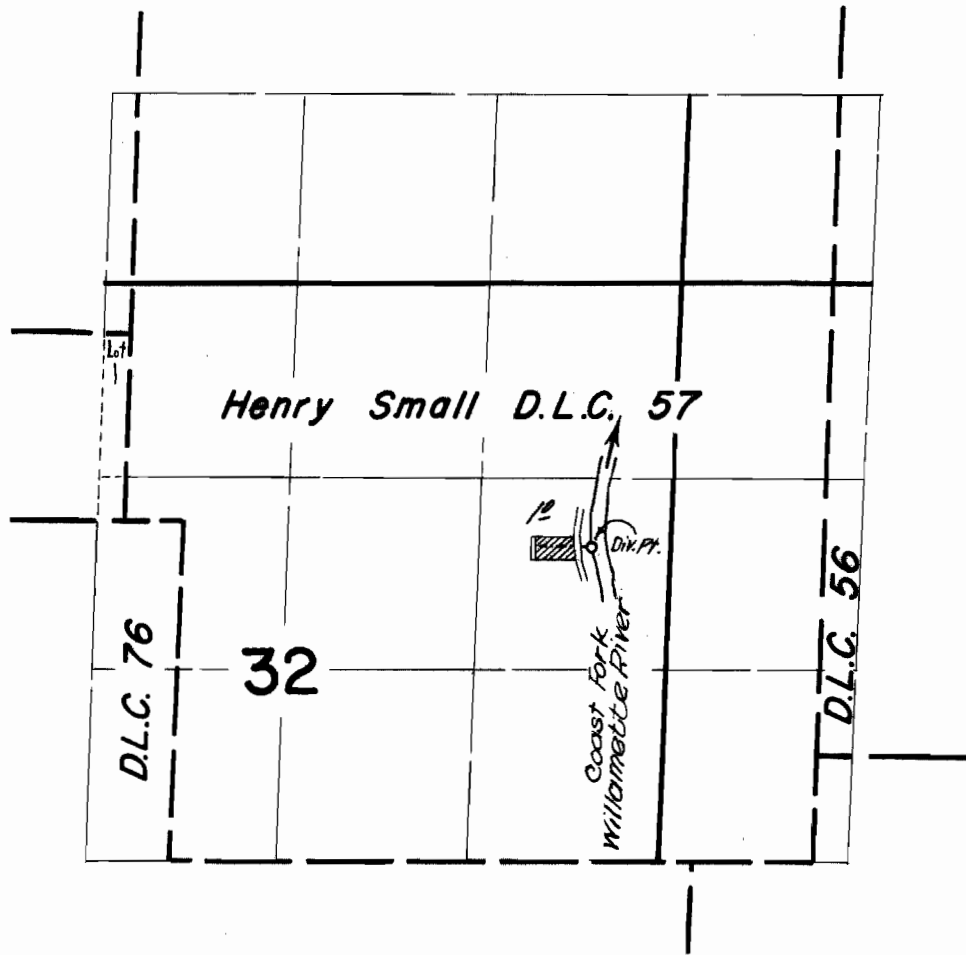

**FINAL PROOF SURVEY**  
UNDER

Application No. 33298... Permit No. 26313...  
IN NAME OF

**WILBUR L. & CAROLYN L. WORKMAN**

Surveyed *May 7, 1963*, by *C. Baker*...