


T.20S.R.3W.W.M.

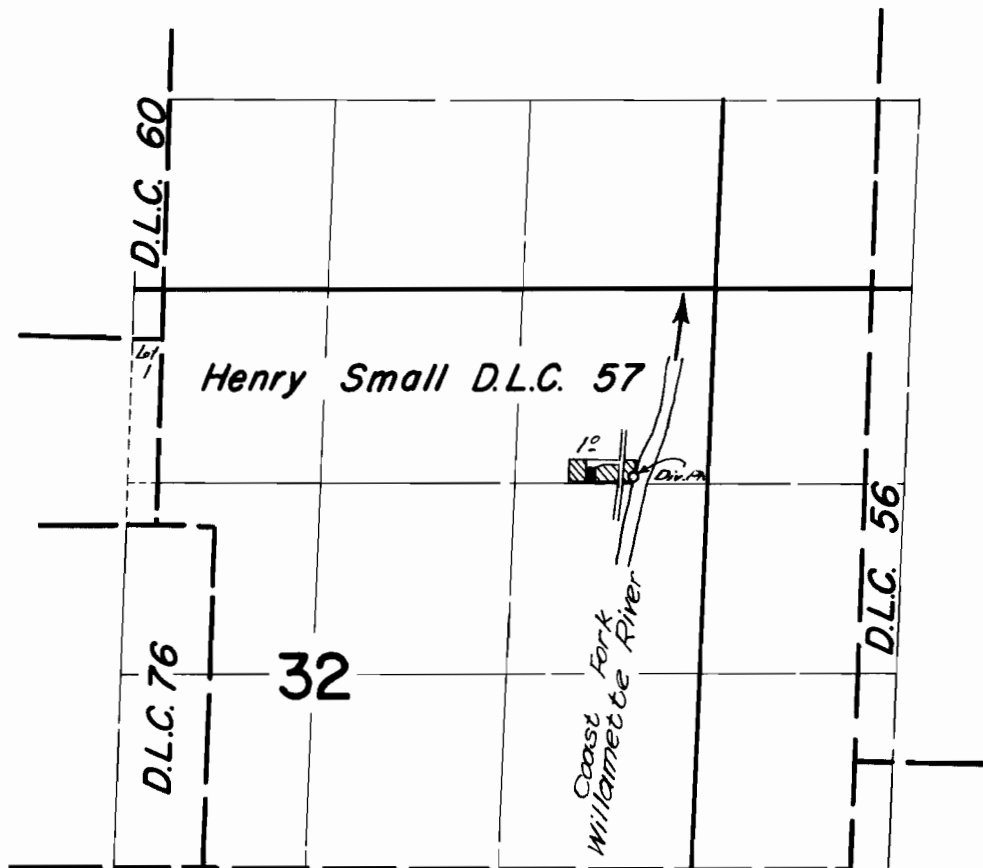

FINAL PROOF SURVEY
UNDER

Application No. **33998** ... Permit No. **26924**...
IN NAME OF

JOSEPH T. & DORIS O. ABBOTT

Surveyed *May 7 1963* by *C. Baker*.