


T.18S. R.2W. W.M.

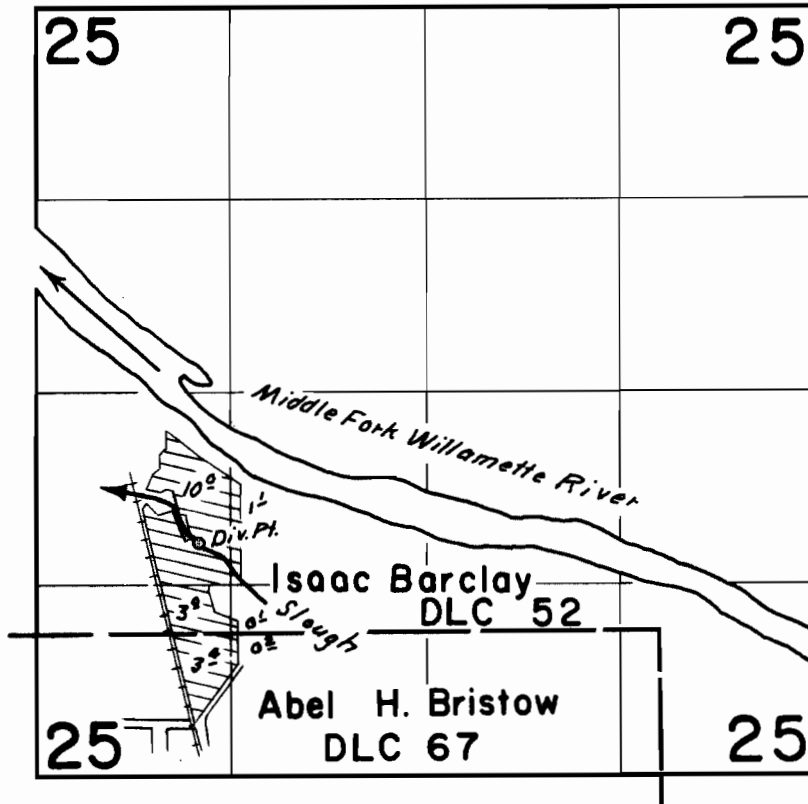

FINAL PROOF SURVEY
UNDER

Application No. 37038... Permit No. 27599...
IN NAME OF

JOHN HRACHOVEC

Surveyed July...7,... 1964., by ..R..Jackson.....