


T.20S. R.3W.W.M.

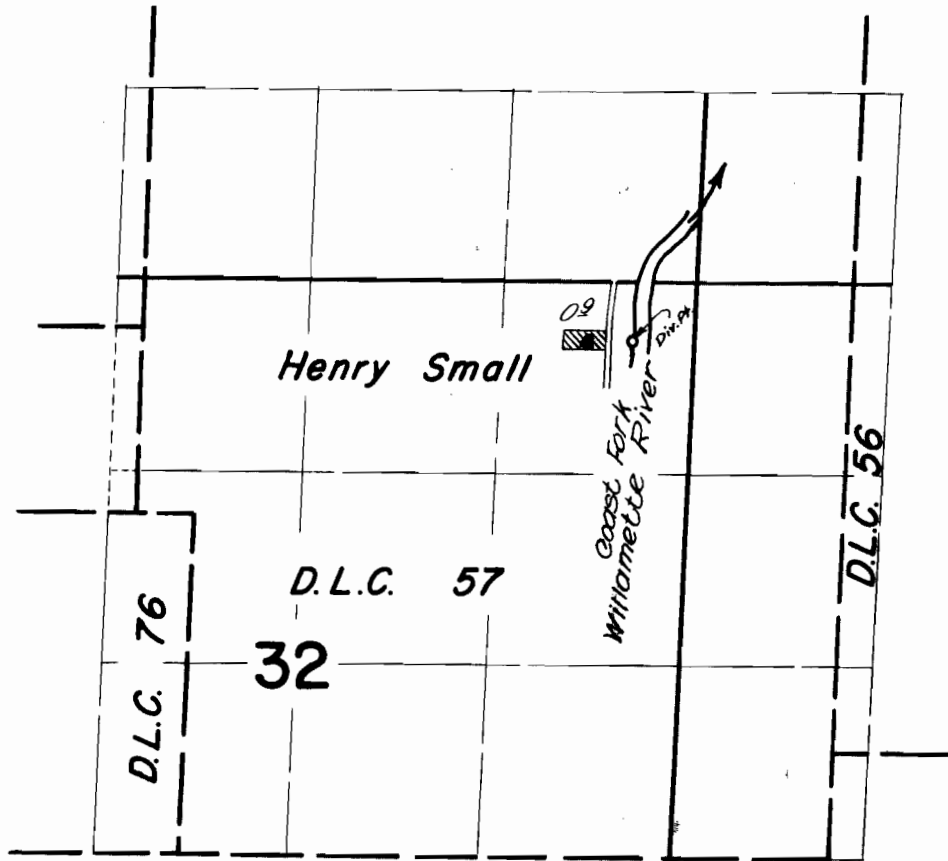

**FINAL PROOF SURVEY**  
UNDER

Application No. 37159... Permit No. 2767.7...  
IN NAME OF

**ROBERT G. & LOIS J. MILLS**

Surveyed July 1, 1964, by *L. Jackson*