


T.19S.R.3W. W.M

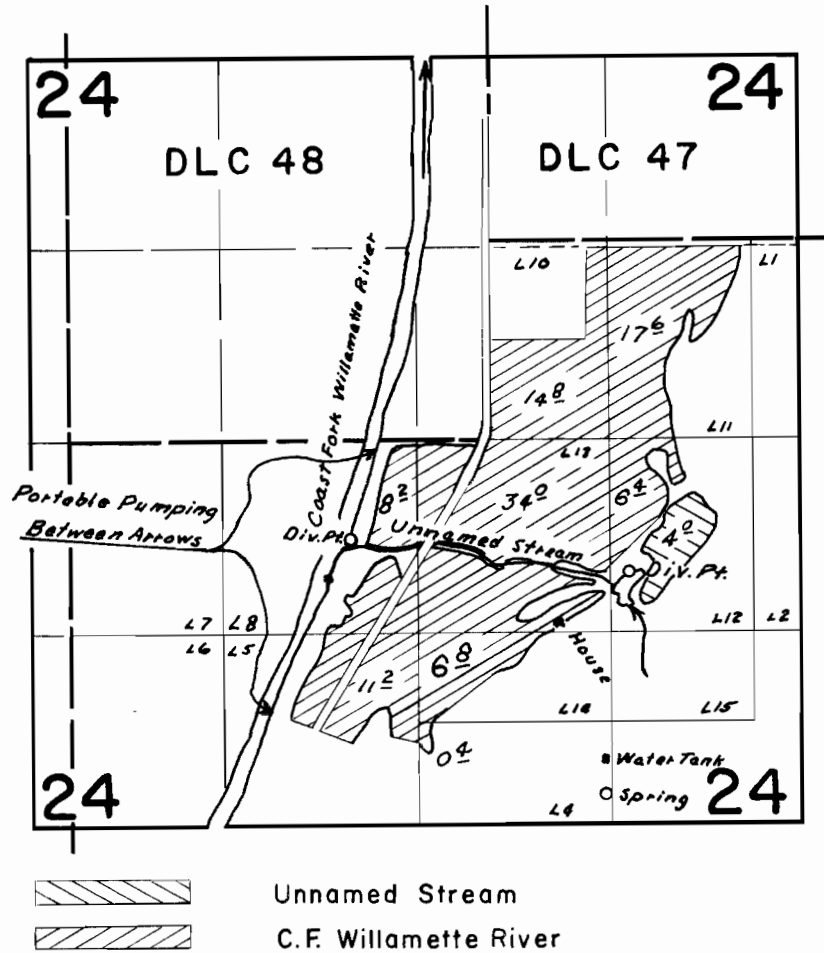

FINAL PROOF SURVEY UNDER

Application No. 37230... Permit No. 27787...
IN NAME OF

ROBERT F. MARQUESS

Surveyed July 7, 1964, by R. Jackson.....