


T.20S.R.3W.W.M.

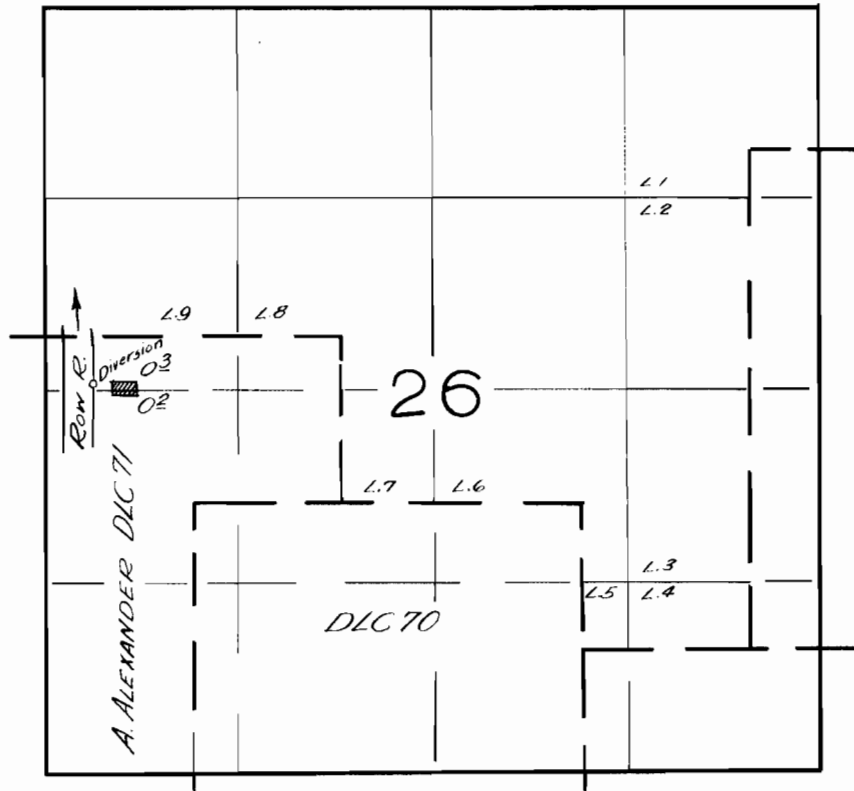

FINAL PROOF SURVEY
UNDER

Application No. *37635* Permit No. *28062*
IN NAME OF

GRIFFITH & JEANNE VARNON

Surveyed *July 2, 1964*, by *R. Jackson*