


T. 20S. R. 3W. W.M.

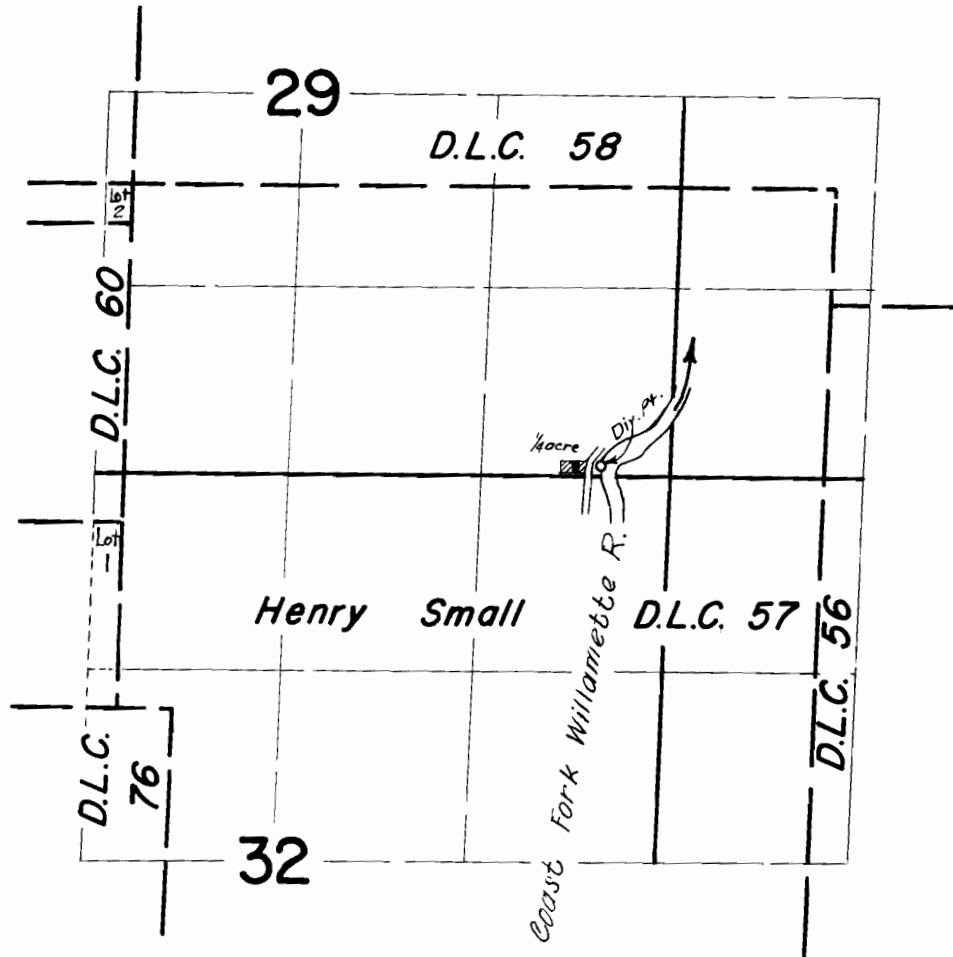

**FINAL PROOF SURVEY**  
UNDER

Application No. **38446** Permit No. **28636**  
IN NAME OF

**LLOYD HOWARD STUMBO**

Surveyed July 3 1964, by *A. Jackson*