


T.14S.R.2E.W.M.

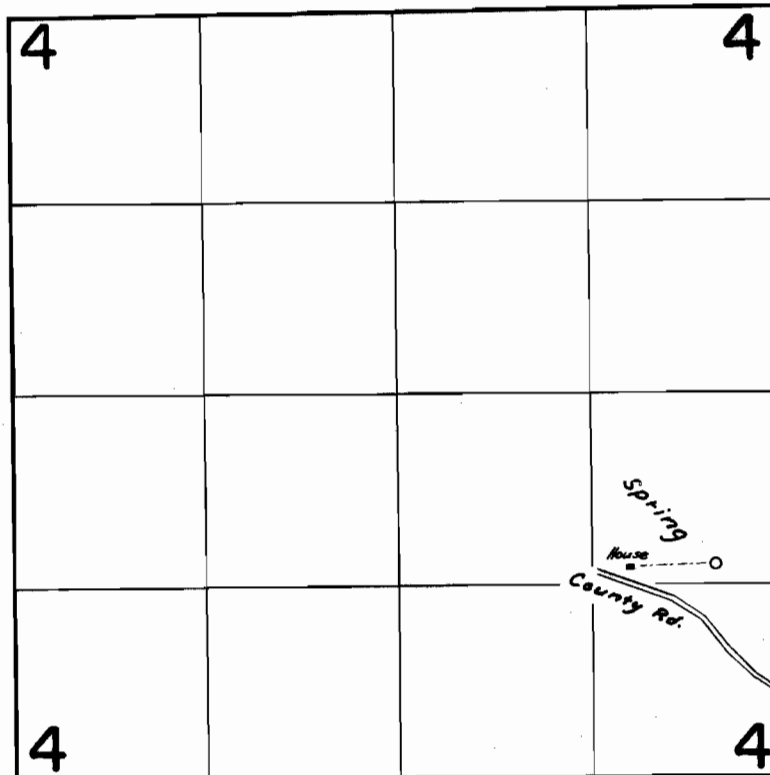

FINAL PROOF SURVEY
UNDER

Application No. 33614 Permit No. 26579
IN NAME OF

FRANK L. & DOROTHY J. CALKINS

Surveyed Nov. 6, 1964, by C.W. Gardner