


# T.11S. R.4W. W.M.

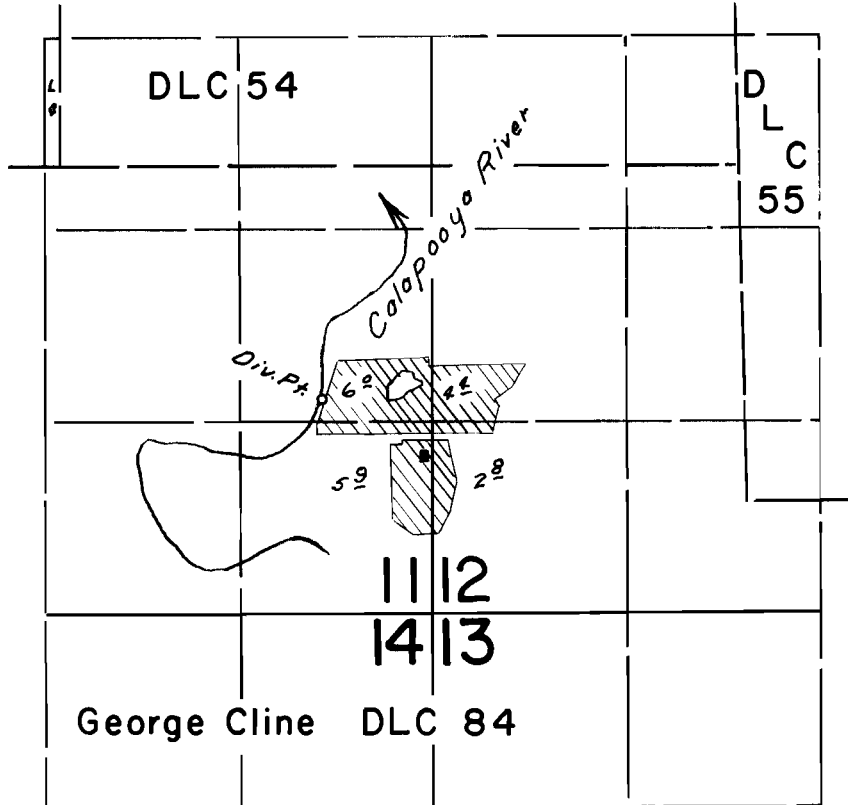

## FINAL PROOF SURVEY UNDER

Application No. 34154 ... Permit No. 26909  
IN NAME OF

**JIM & ALTON SULLIVAN**

Surveyed Oct. 15, 1964, by *C.J. Gardner*