


T.13S.R.1E.W.M.

Jason L. Williams

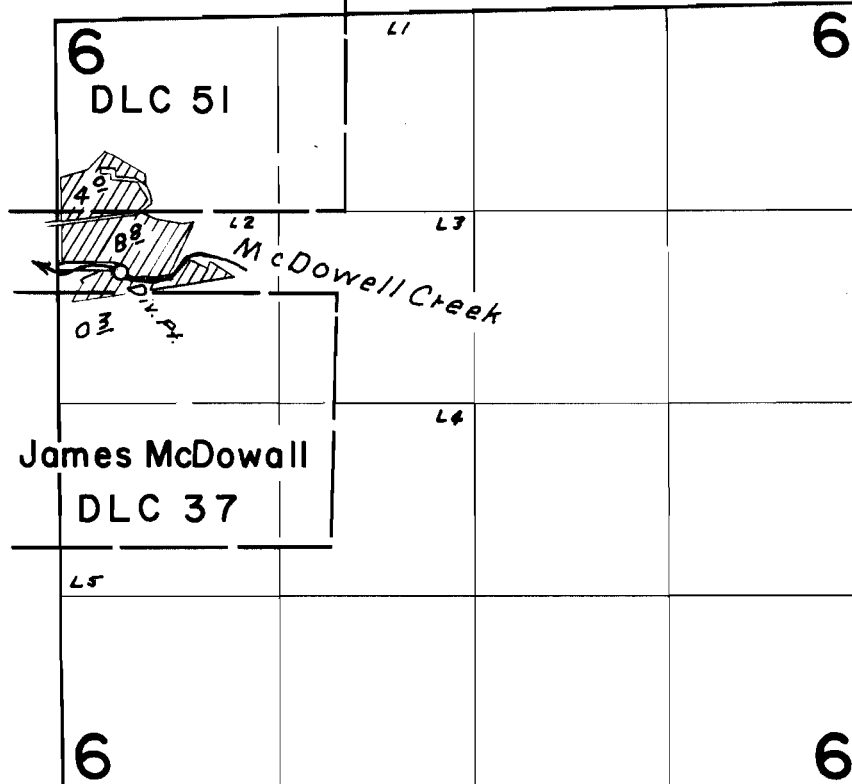

FINAL PROOF SURVEY UNDER

Application No. 34414 Permit No. 27031
IN NAME OF

EARL L. & ELSIE R. WILKINSON

Surveyed Nov. 5, 1964, by C. J. Gardner