


T.14S.R.1W.W.M.

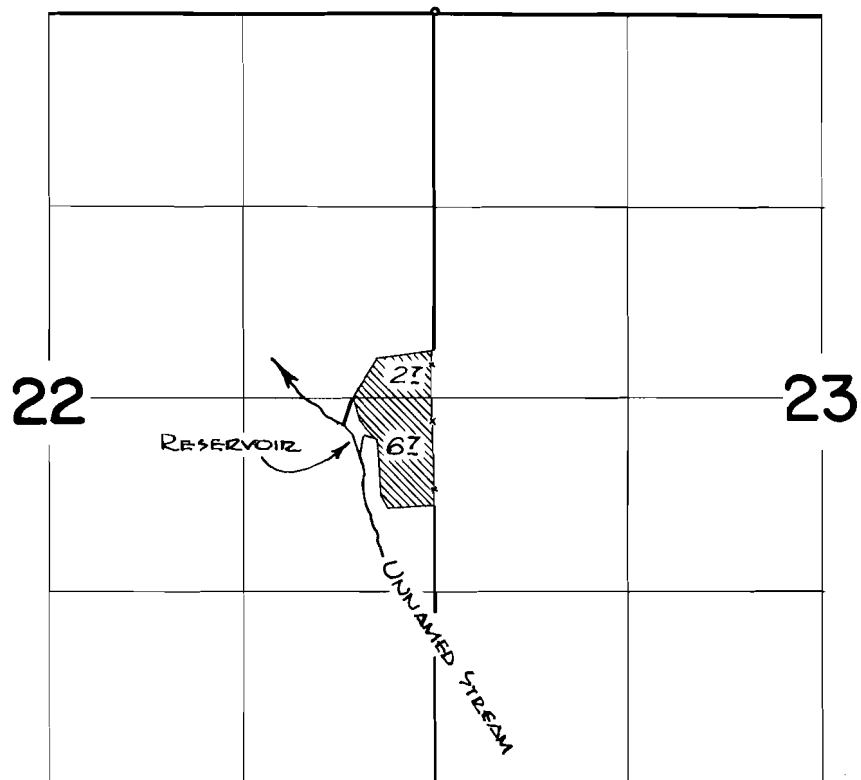

FINAL PROOF SURVEY
UNDER

Application No. **R-34932** Permit No. **R-2616**
34933 **27381**
IN NAME OF

JAMES E. & DONNA L. LUTTON

Surveyed May 31, 1963, by C. BAKER