


T.10S.R.2W.W.M.

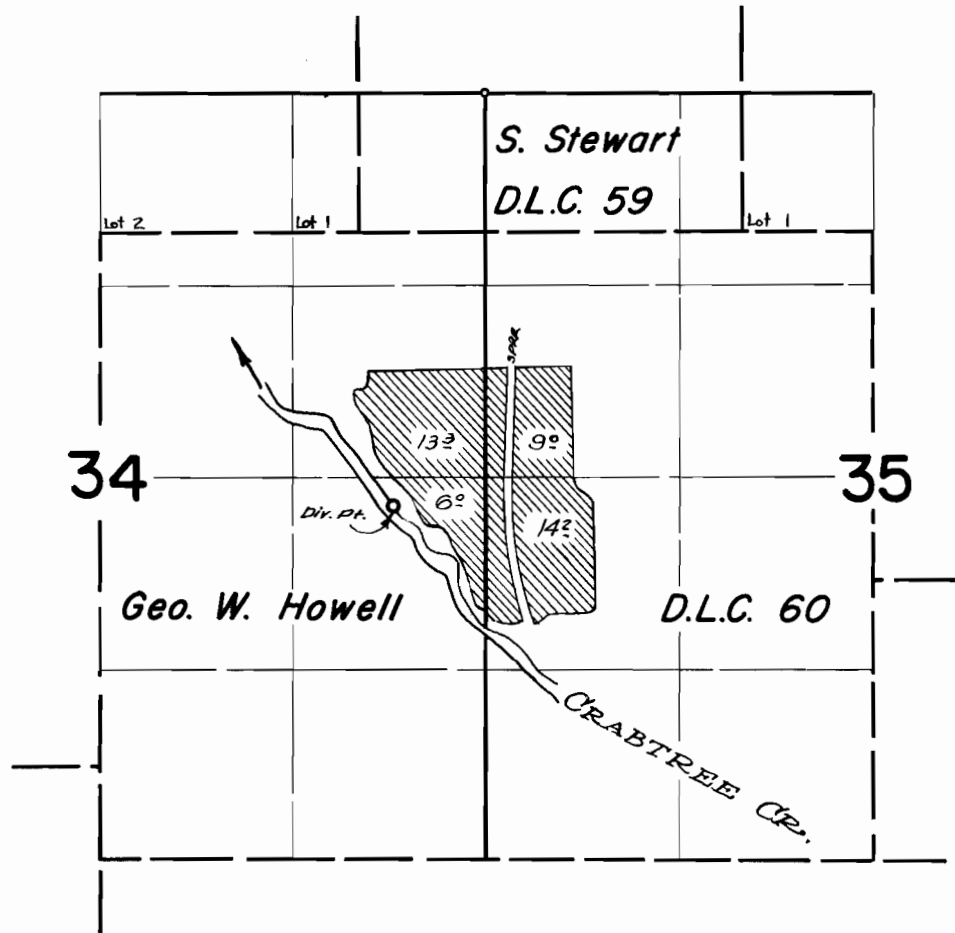

FINAL PROOF SURVEY
UNDER

Application No. 37482... Permit No. 27903...
IN NAME OF

ROBERT C. & ROBERT O. FORSON

Surveyed Sept. 5, 1963, by C. Baker.....