


T.11S.R.4W. W.M.

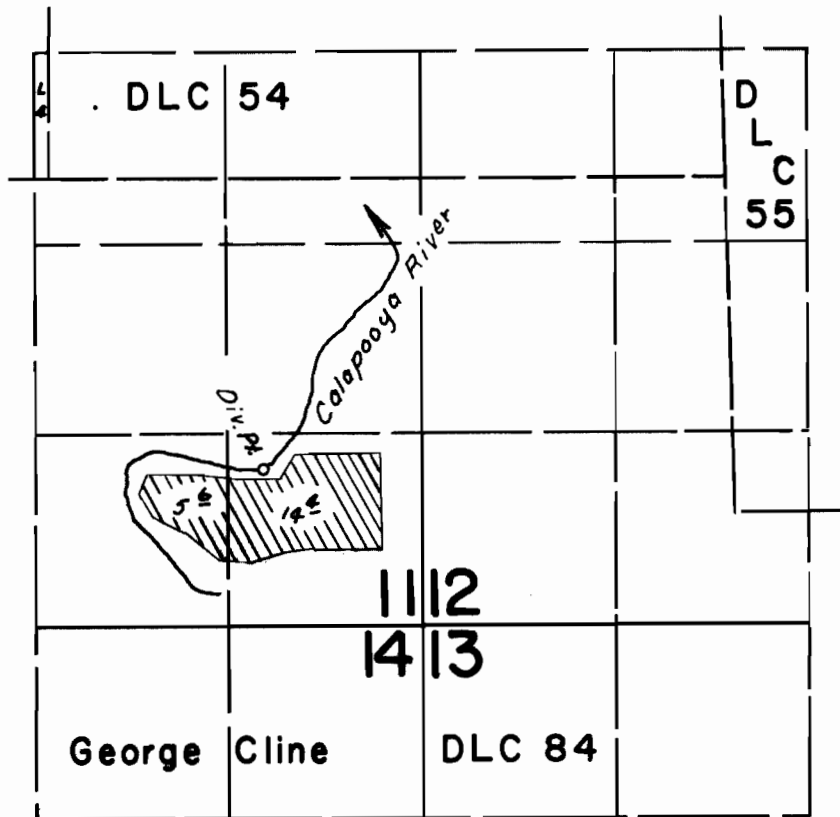

FINAL PROOF SURVEY
UNDER

Application No. 38906... Permit No. 28960
IN NAME OF

ELMER & LAURA LEE CLUM

Surveyed Oct. 15, 1964, by C.J. Gardner...