


T. 14 S.R. 39 E.W.M.

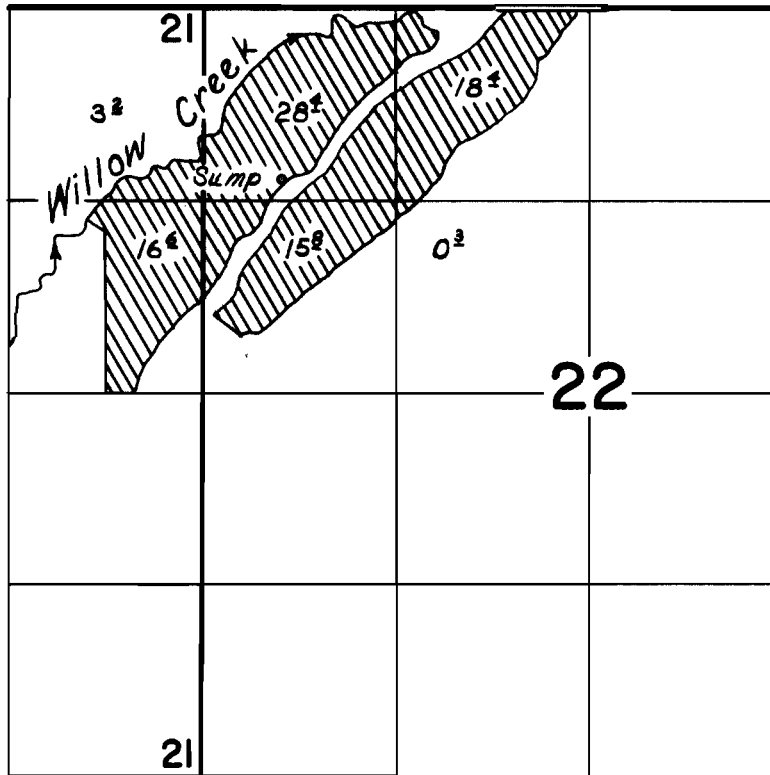

FINAL PROOF SURVEY UNDER

Application No. *G-1406* Permit No. *G-1281*
IN NAME OF

MARVIN E. & MARIE G. OGILVIE

Surveyed *July 13 1962*, by *C.R. Baker*