


T. 18 S.R. 45 E.W.M.

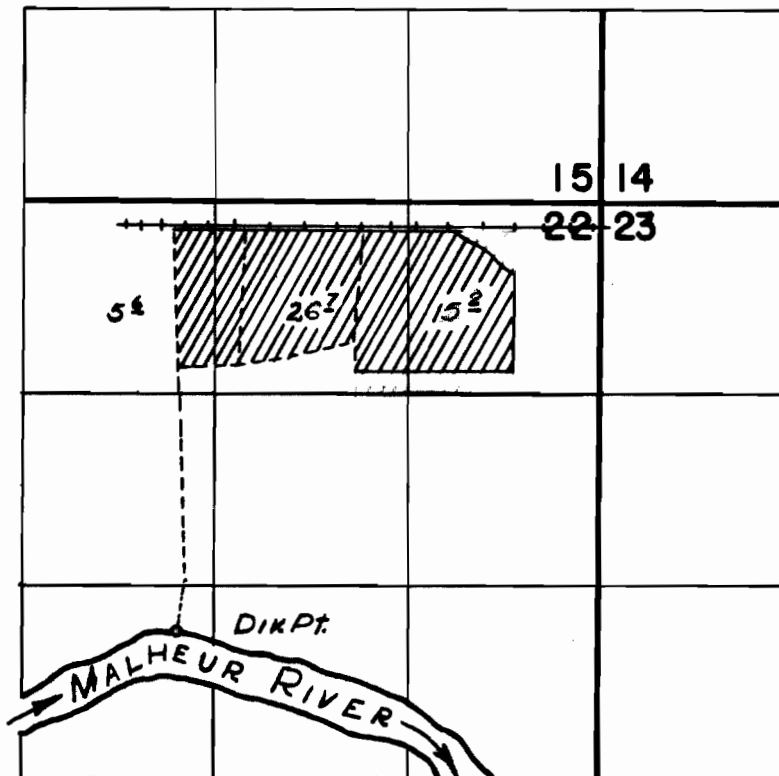

FINAL PROOF SURVEY UNDER

Application No. 312.77. Permit No. 24955.
IN NAME OF

FRED W. & ECHO M. FISH.....

Surveyed June 11, 1962, by C.R. Baker.....