


T.4S.R.2W.W.M.

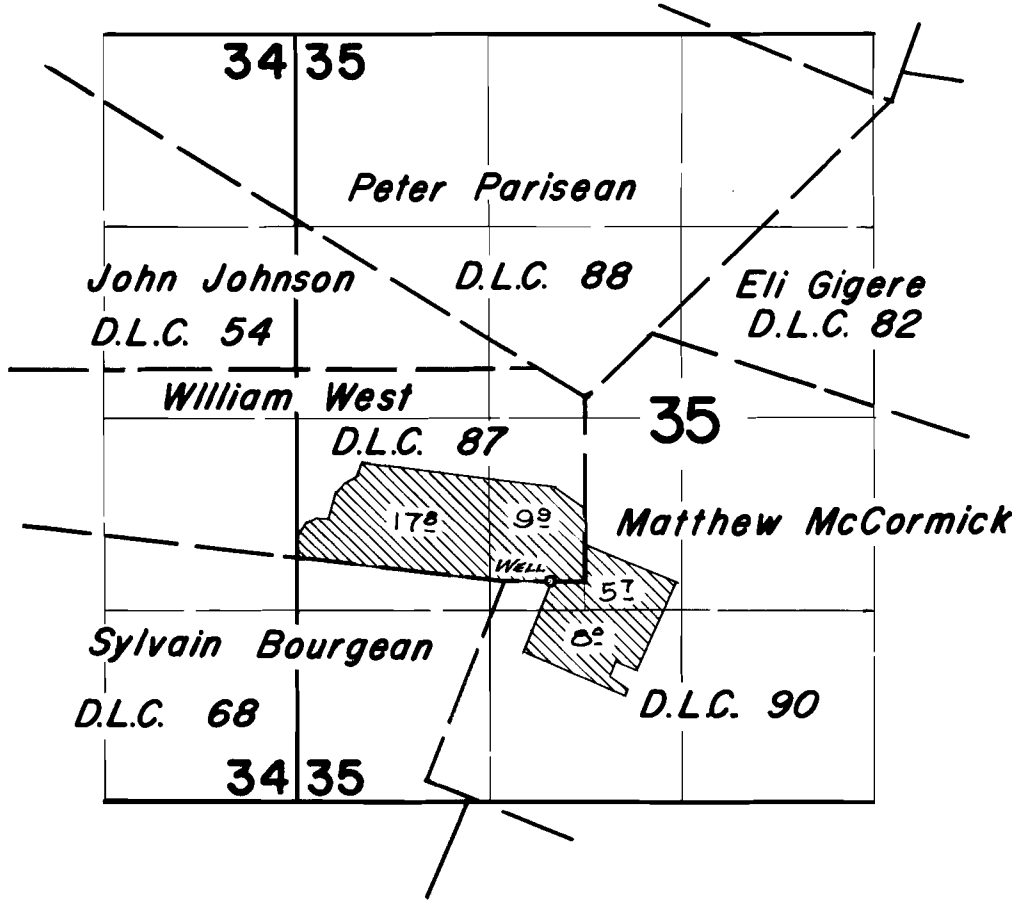

**FINAL PROOF SURVEY**  
UNDER

Application No. **G-1923** Permit No. **G-1767**  
IN NAME OF

**PATRICK J. & DOLORES A. JOHNSTON**

Surveyed *April 23 1963*, by *T. Lauer*