


T.6S.R.3W.W.M.

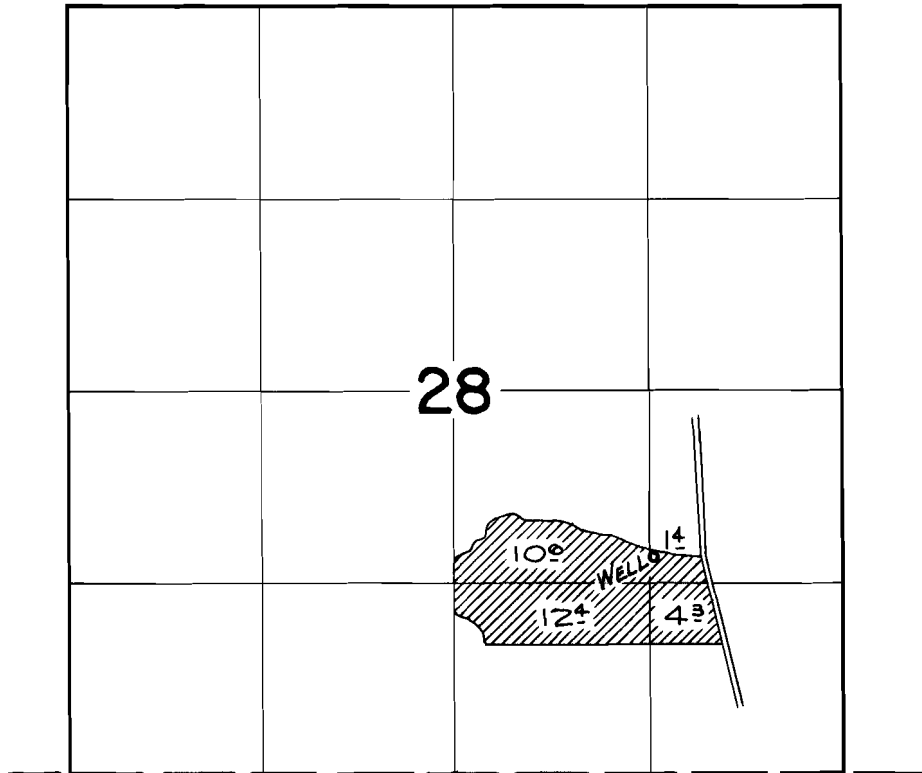

FINAL PROOF SURVEY
UNDER

Application No. G-2058 Permit No. G-1887
IN NAME OF

FRED MCCALL

Surveyed April 25 1963, by T. Lauer

RL