


T. 5 S. R. 3 W. W. M.

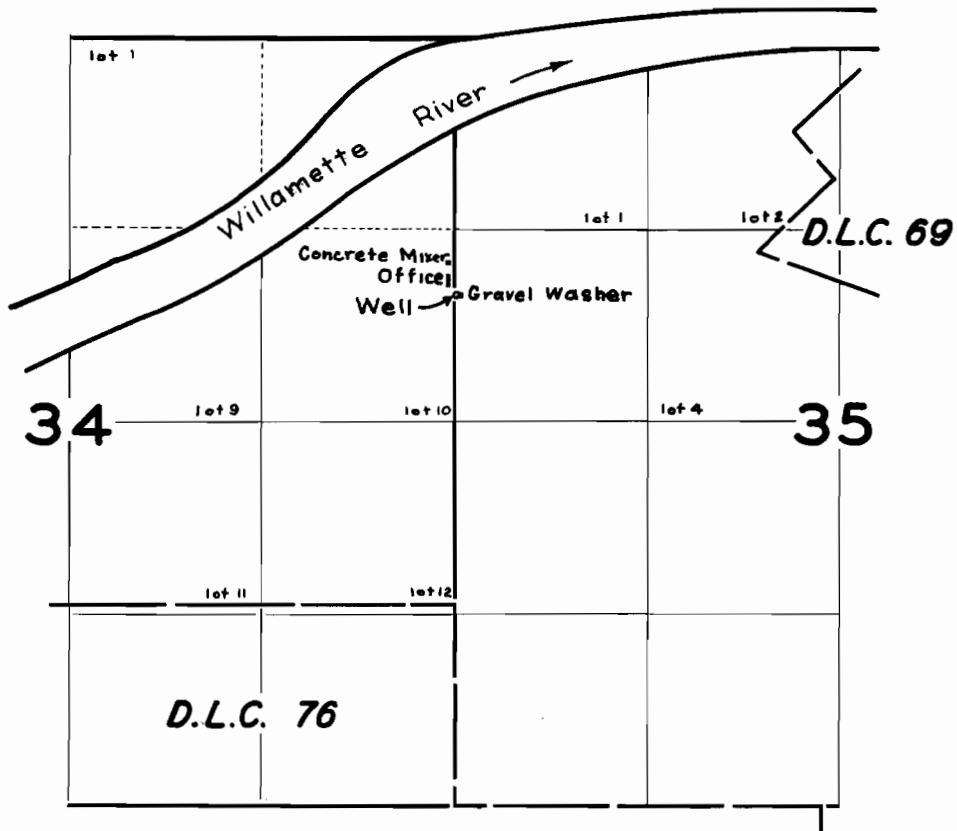

**FINAL PROOF SURVEY**  
UNDER

Application No. G-2452 Permit No. G-2301  
IN NAME OF

**VIESKO SAND & GRAVEL**

Surveyed APR. 19, 1963, by T. LAUER