


T.I.S.R. 4E.W.M.

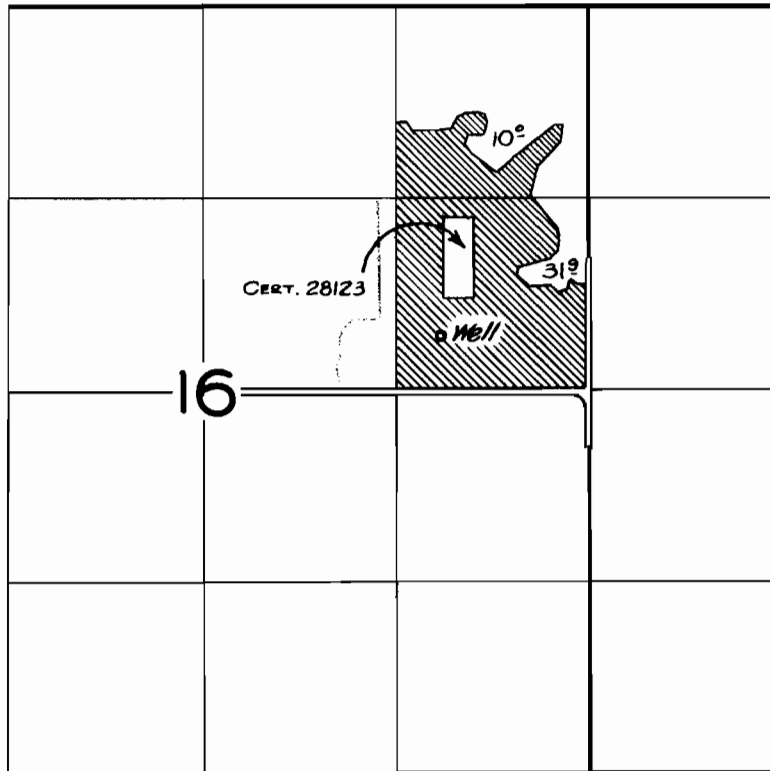

FINAL PROOF SURVEY
UNDER

Application No. G-1751... Permit No. G-1613...
IN NAME OF

ANDREW & ANNE SHERWOOD

Surveyed August 2, 1963, by T. Lauer...