


# T.I.S.R.3E.W.M.

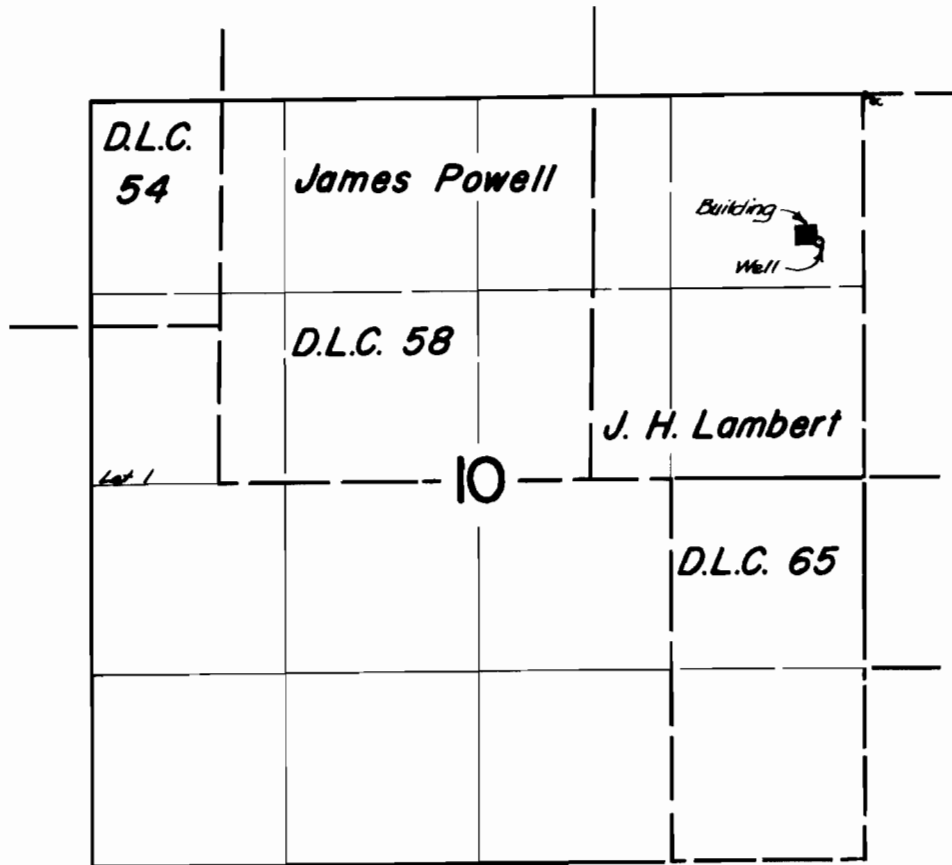

## FINAL PROOF SURVEY UNDER

Application No. G-2250 Permit No. G-2069  
IN NAME OF

PORTLAND GENERAL ELECTRIC CO.

Surveyed July 24 1963, by T. Lauer