


T. IS. R. 3 E. W. M.

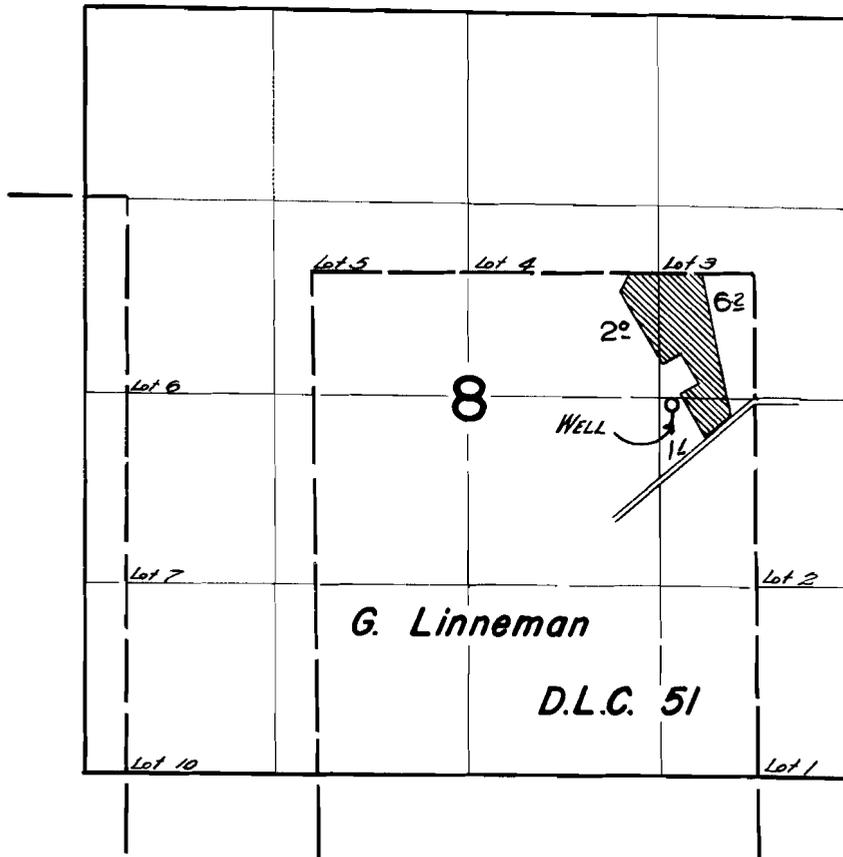

FINAL PROOF SURVEY UNDER

Application No. G-1976 Permit No. G-1812
IN NAME OF

RAYMOND BECHTOLDT

Surveyed July 23 1963, by T. Lauer

Rf