


T.I.S.R.3E.W.M.

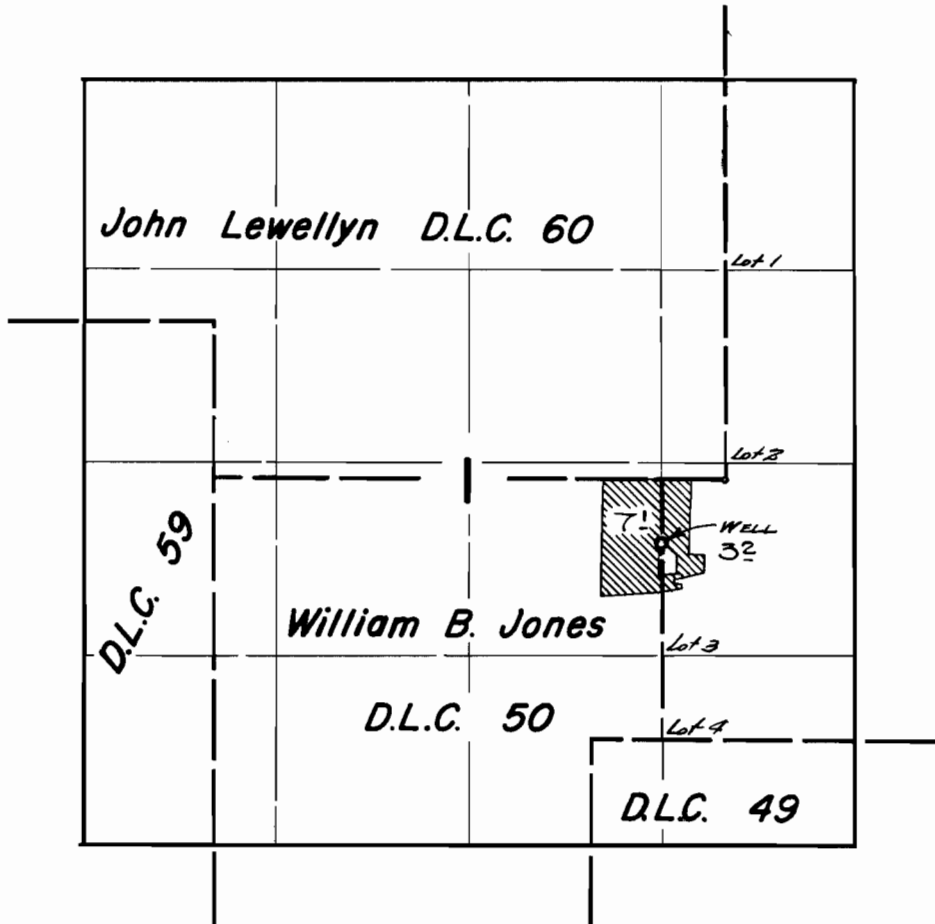

FINAL PROOF SURVEY UNDER

Application No. G-2317 Permit No. G-2143
IN NAME OF

WALTER W. ASAKAWA

Surveyed August 1, 1963, by T. Lauer