


T.9S.R.6 W.W.M.

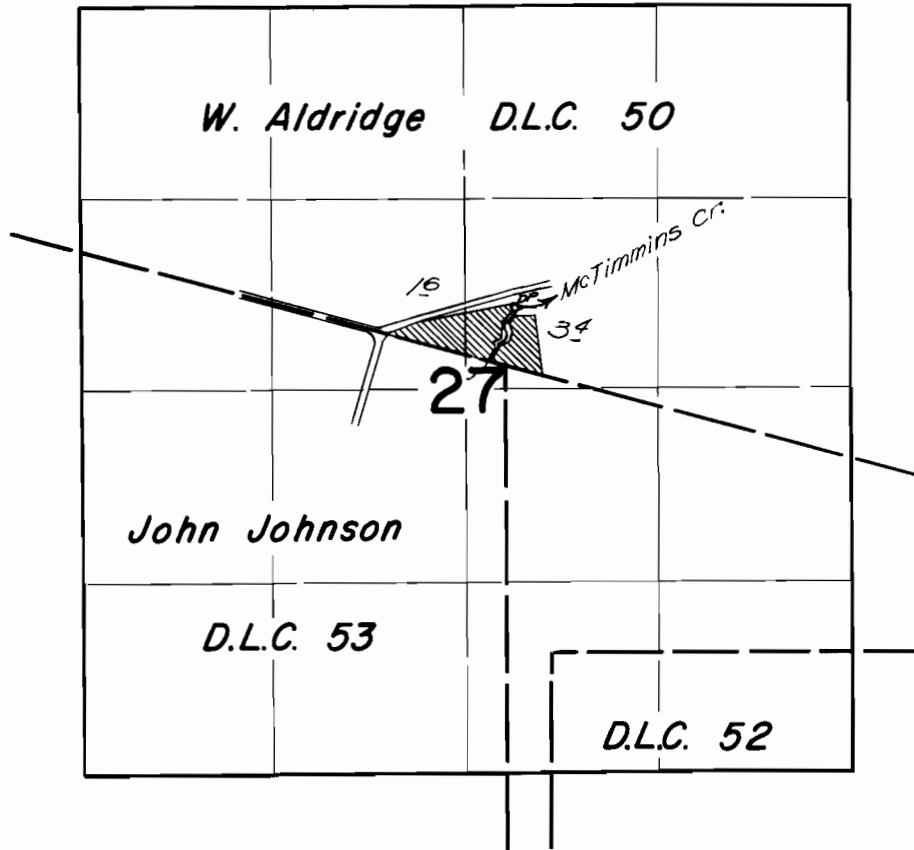

FINAL PROOF SURVEY UNDER

Application No. **34618** . Permit No. **27181**.....
IN NAME OF

PAUL MADDUX

Surveyed *Oct. 25 1963*, by *C. Baker*.....