


# T.9S.R.5W.W.M.

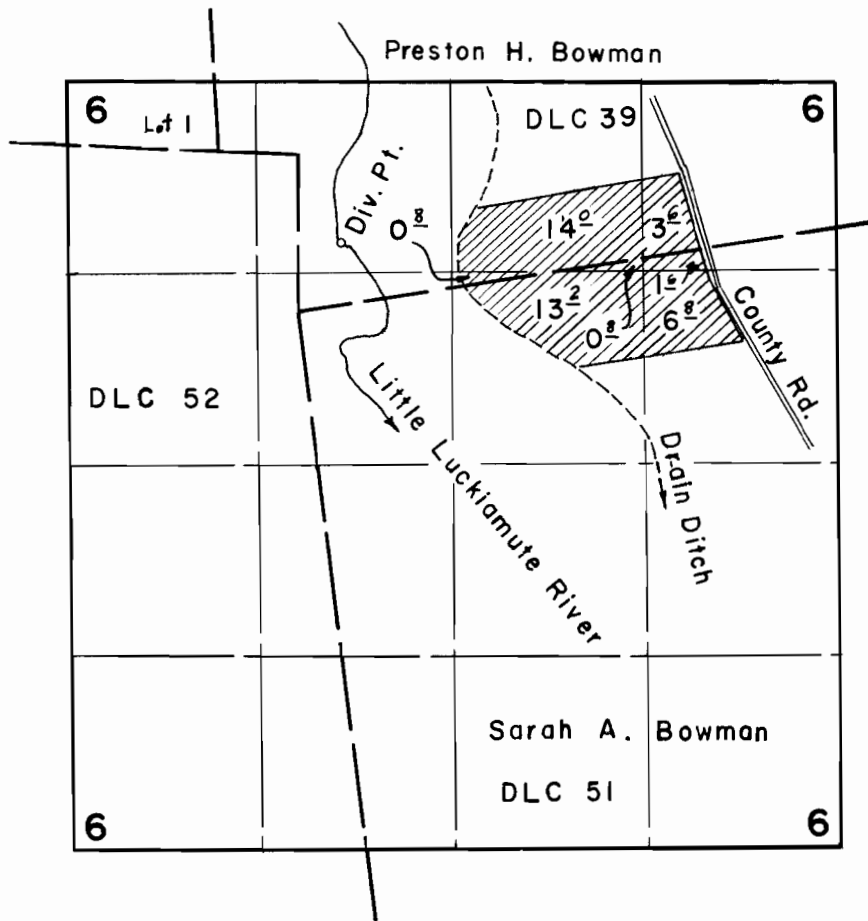

## FINAL PROOF SURVEY UNDER

Application No. 38286... Permit No. 28520...  
IN NAME OF

..... Clinton M. Ruiter .....

Surveyed Sept. 23, 1964, by C.J. Gardner.....