


T.9S.R.6W.W.M.

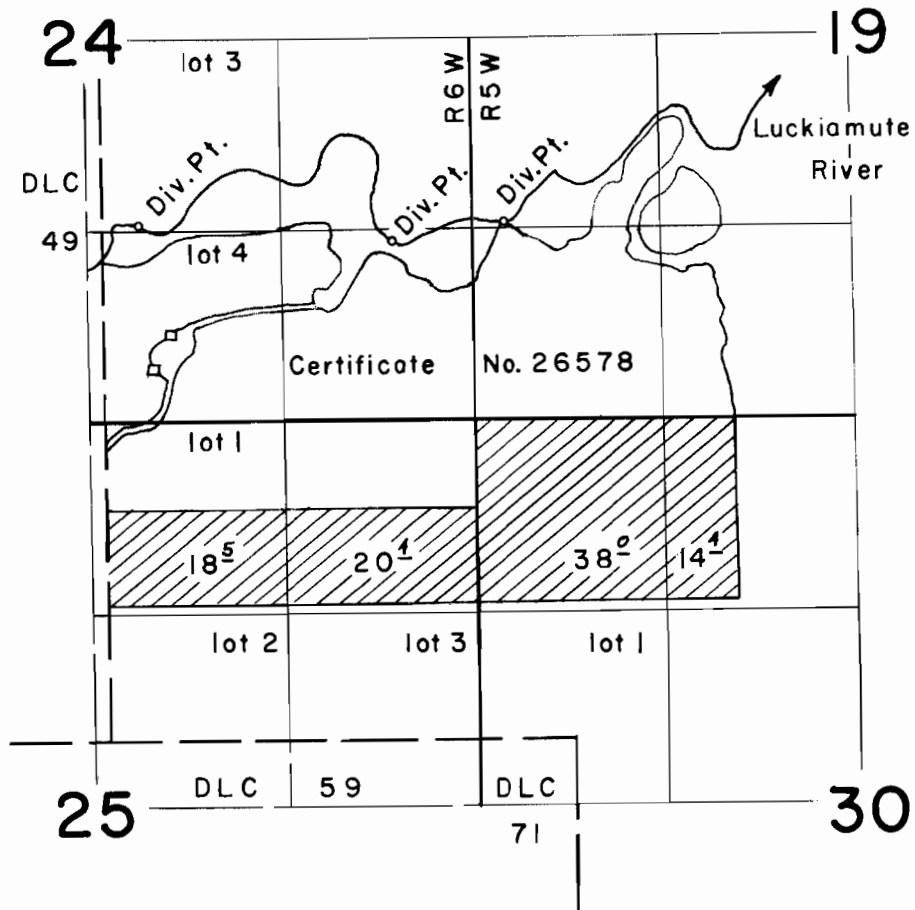

FINAL PROOF SURVEY UNDER

Application No. 38367... Permit No. 28593...
IN NAME OF

V. L. Mathany

Surveyed Sept. 23 1964, by C. J. Gardner