


T.7S.R.3W. W.M.

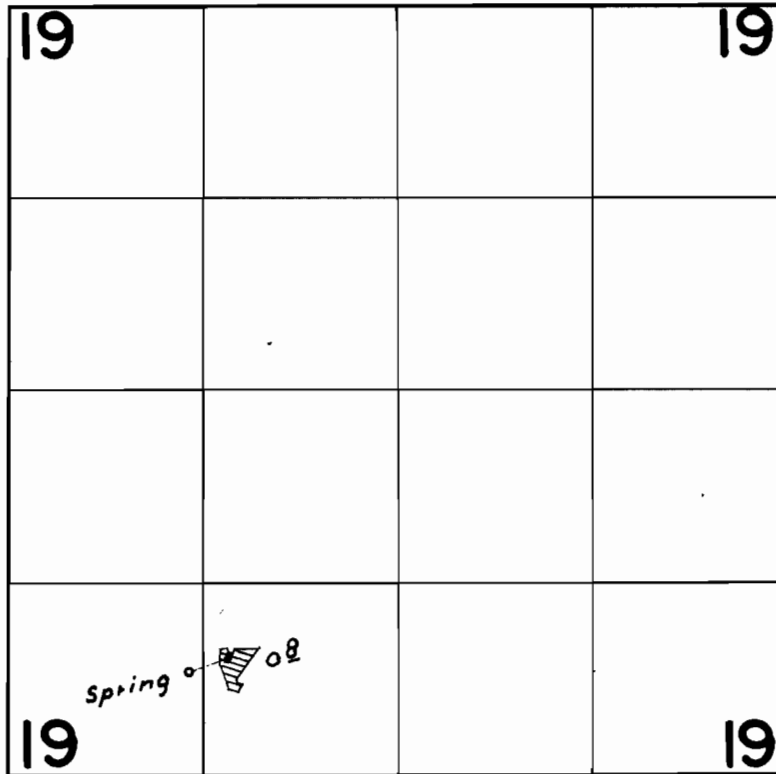

FINAL PROOF SURVEY
UNDER

Application No. 39184 Permit No. 29140
IN NAME OF

PETER STEEVES MORSE

Surveyed Sept. 22, 1964., by C.J. Gardner