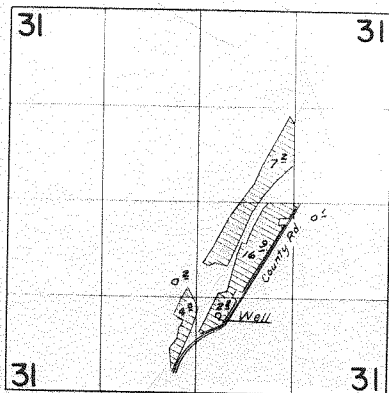


T.3N. R.33E. W.M.

**FINAL PROOF SURVEY  
UNDER**

Application No. G-213 Permit No. G-132  
IN NAME OF  
**JAMES RUTTEN**

Surveyed August 18, 1964, by C.V. Gardner