


T.I.S.R.32E.W.M.

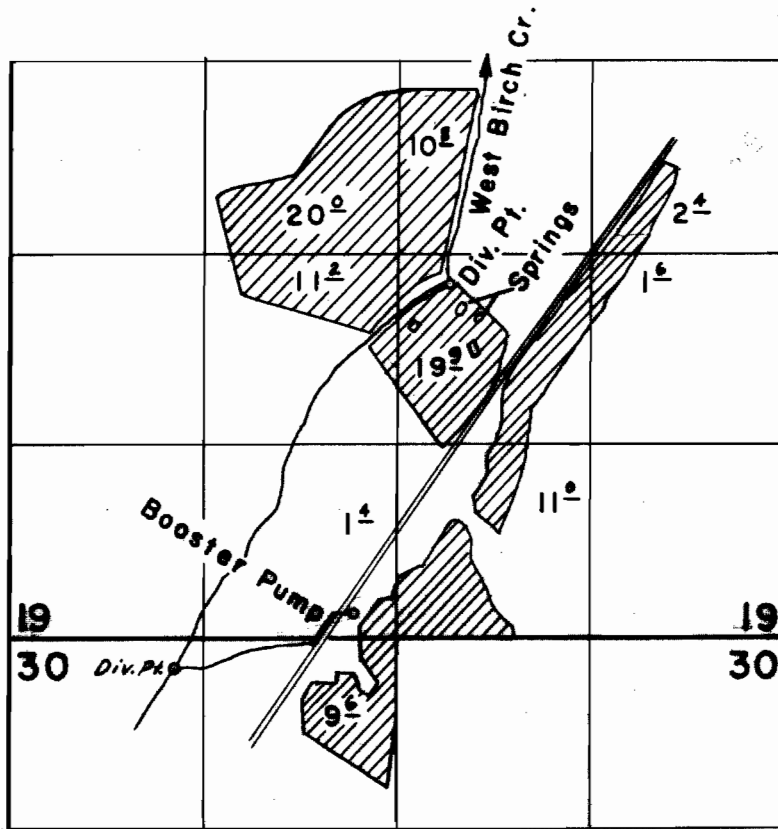

FINAL PROOF SURVEY UNDER

Application No. 34282... Permit No. 27002...
IN NAME OF

Arnold Hoeft

Surveyed Aug. 20, 1964, by C.J. Gardner...