


T.1N.R.39E.W.M.

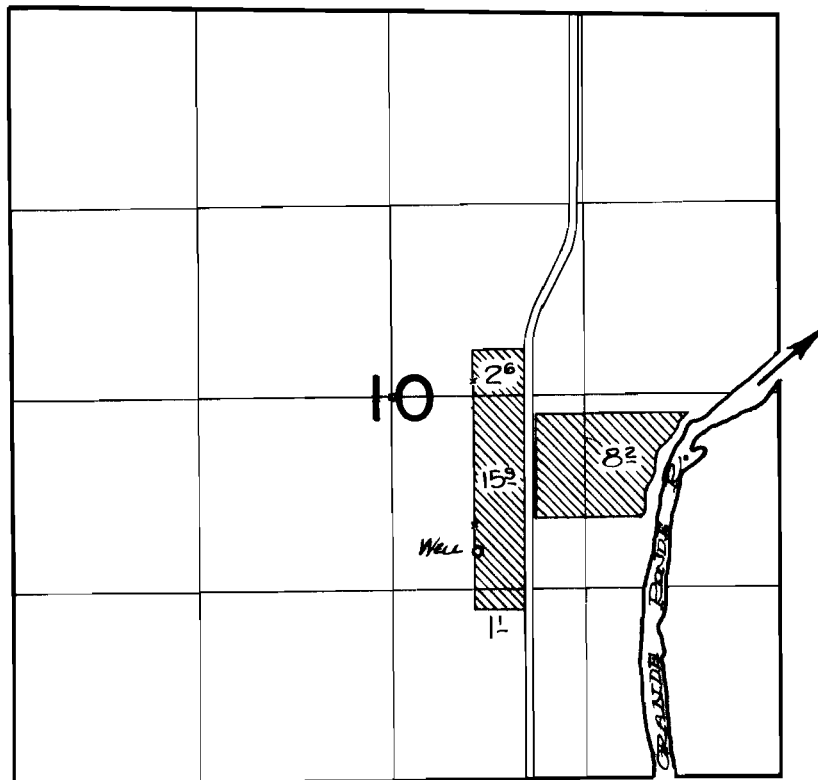

FINAL PROOF SURVEY UNDER

Application No. G-1106 Permit No. G-1040
IN NAME OF

ERNEST E. ADAMS

Surveyed Sept. 24 1963, by T. Lauer