


T.2S.R.38E.W.M.

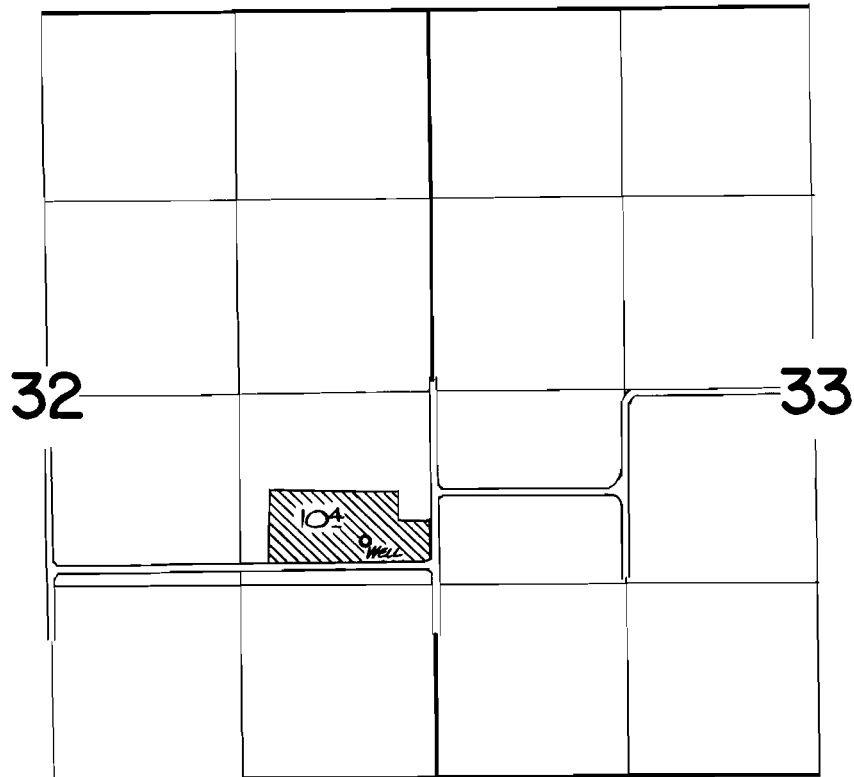

FINAL PROOF SURVEY
UNDER

Application No. **G-2098** Permit No. **G-1929**
IN NAME OF

CHARLES & VELMA WALNUM

Surveyed Sept. 26 1963, by T. Lauer