


T. IS. R. 39 E. W. M.

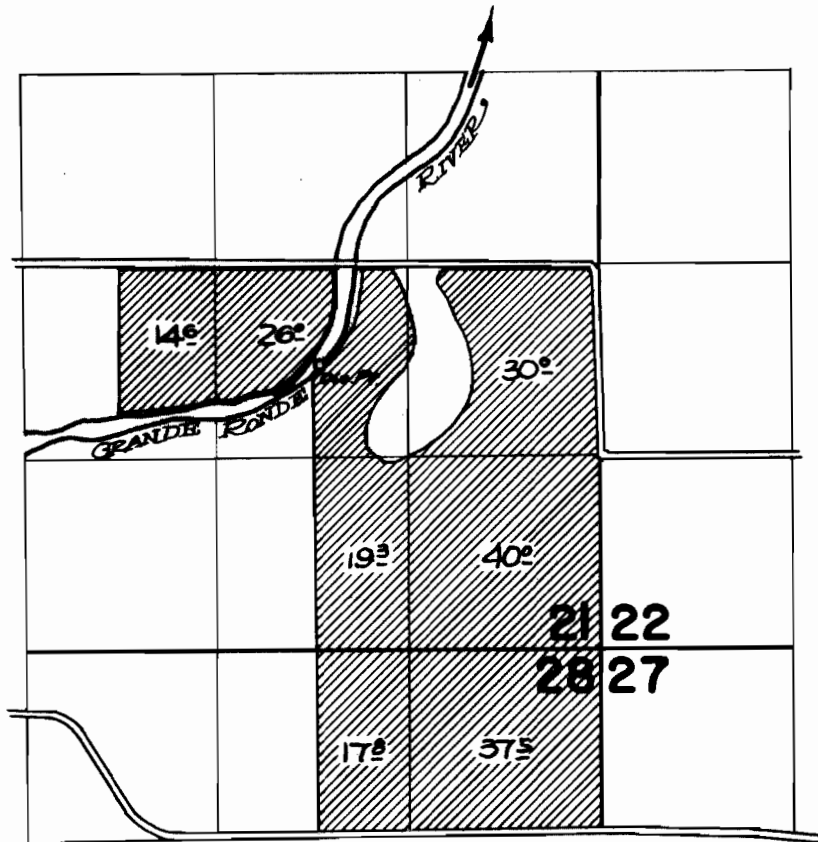

FINAL PROOF SURVEY
UNDER

Application No. 32226 Permit No. 25522
IN NAME OF

JACOB LEMAR WESTENSKOW

Surveyed *Sept. 20 1963*, by *T. Lauer*

PL