


T.IS.R.39E.W.M.

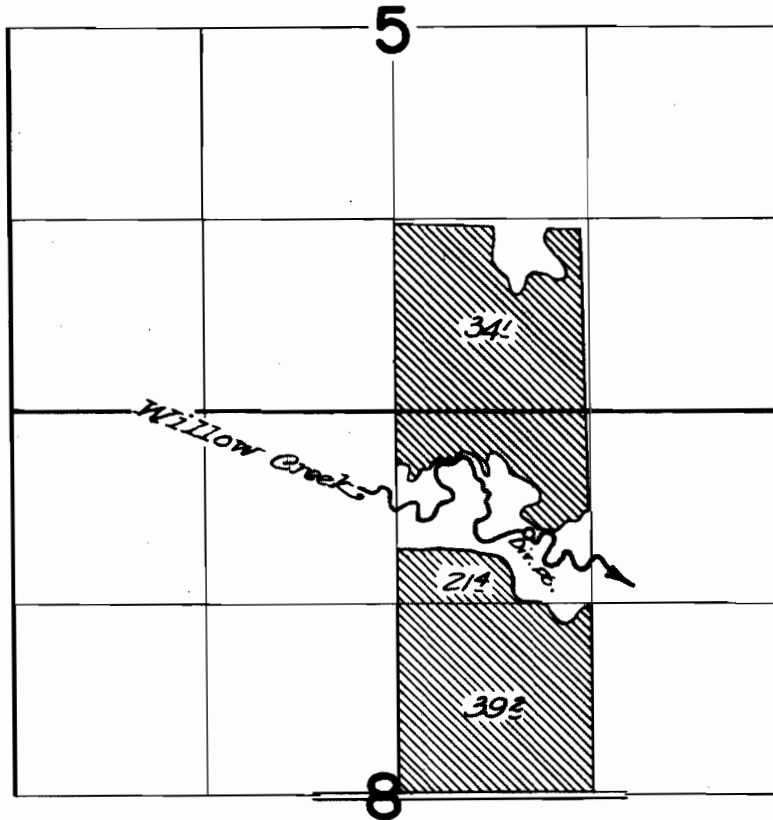

FINAL PROOF SURVEY UNDER

Application No. 33342 Permit No. 26367
IN NAME OF

C. H. TUTTLE

Surveyed *Sept. 26* 1963, by *T. Lauer*

TL