


T.1S.R.39E.W.M.

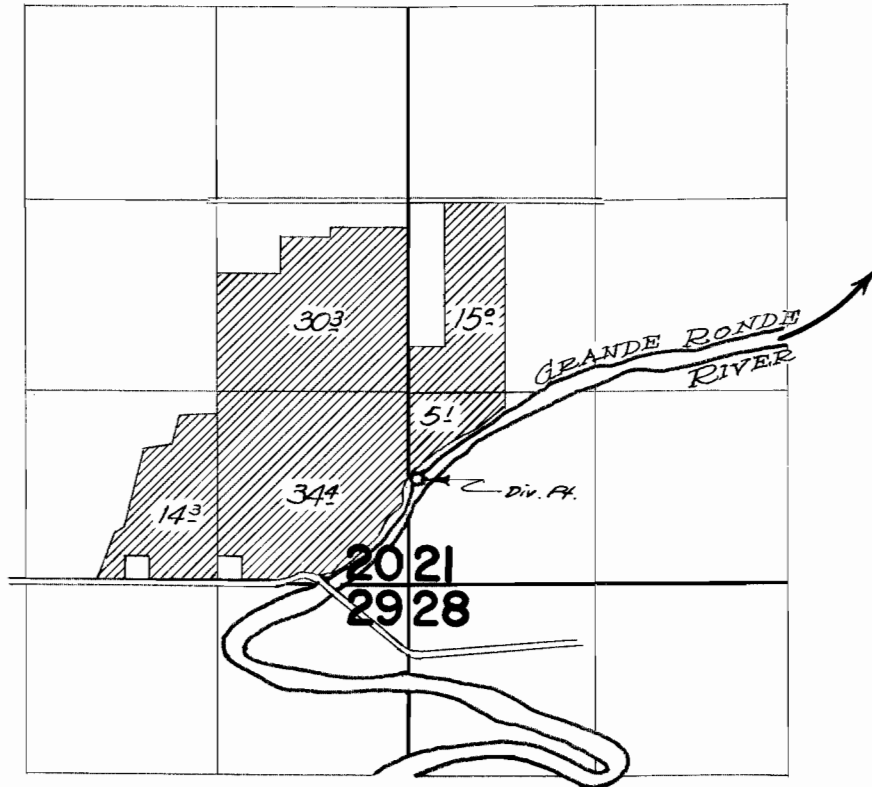

FINAL PROOF SURVEY UNDER

Application No. **33762** Permit No. **26657**
IN NAME OF

CLAYTON FOX

Surveyed *August 25 1963*, by *T. Lauer*