


T.I.S.R.38E.W.M.

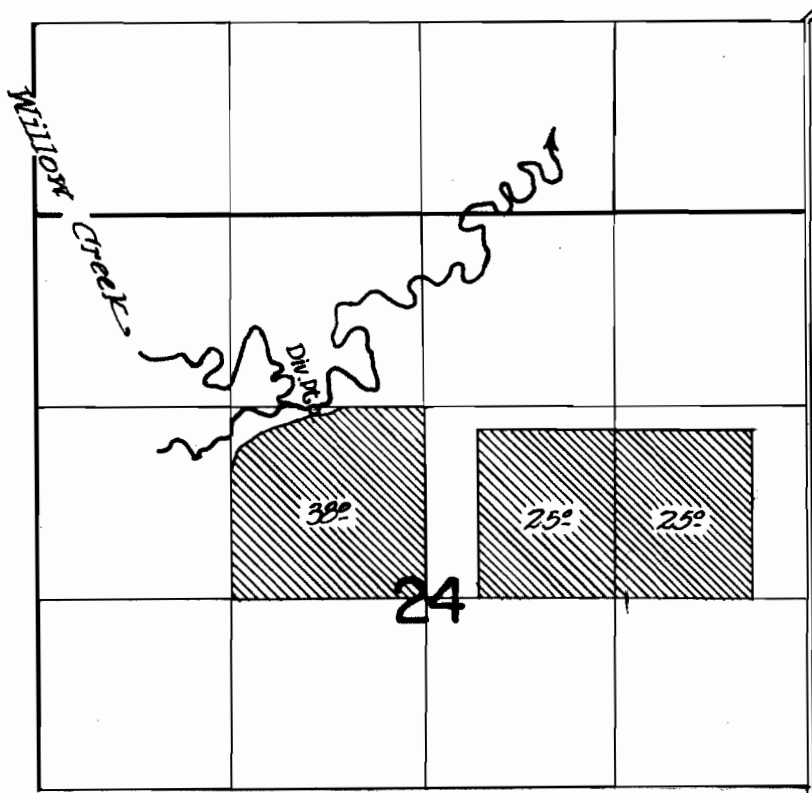

FINAL PROOF SURVEY UNDER

Application No. 34766... Permit No. 27291...
IN NAME OF

ALFRED A. & BONNIE J. ARNOLDUS

Surveyed Sept. 30, 1963, by T. Lauer.....